

APR 08 1996

COMMISSION

LAND CORNER RECORDATION CERTIFICATE
Filing Requirement of Act 74, Mich. P.A. 1970

For corners in

Manistee

(County)

Located In:

Corner Code #

1. Public Land Survey

T	21N	R	13W	A-8	<input checked="" type="checkbox"/>
T		R			
AND T	21	R	14W	M-8	
T		R			

REGISTER'S OFFICE
MANISTEE COUNTY

#93-366 AT 11:43 A.M.

MAY 24 1993

Penny A. Peper
REGISTER OF DEEDS

Register of Deeds Stamp & File Number

2. Property Controlling
in Section

S		T		R	
S		T		R	

3. Miscellaneous
Property in Sec.

S		T		R	
S		T		R	

4. Lot No. _____, Recorded Plat _____

5. Private Claims _____

	A	B	C	D	E	F	G	H	I	J	K	L
2	6		5		4		3		2			
3												
4	7		8		9		10		11			
5												
6	18		17		16		15		14			
7												
8	19		20		21		22		23			
9												
10	30		29		28		27		26			
11												
12	31		32		33		34		35			
13												

Norman C. Caldwell, in a field survey on January 19 93

do hereby certify that under requirements of P.A. 74, Michigan P.A. of 1970, the corner points mentioned in lines 1 and 2 above were in conformance with regulations and rules therefore as required in the current manual of survey instructions of the United States Department of the Interior, Bureau of Land Management or by a decree of a Court of Law and/or that the corner points mentioned in lines 3, 4 and 5 above were in conformance with the rules of the Michigan Board of Land Surveyors or by a Decree of a Court of Law; established, re-established, monumented, re-monumented, recovered, found as expressed below:


NOTE: Not more than 4 corners, all in the same town and range, may be recorded on this certificate.

A. Description of original monument and accessories and/or subsequent restoration:

A-8 Post Placed by John Brink, 1837.
N58 1/2°W 73 lks. (48.18') 7" Maple
N11°W 27 lks. (17.82') 9" Maple

B. Description of corner evidence found and/or method applied in restoring or reestablishing corner:

A-8 W 1/4 cor., Sec. 19, T21N-R13W
Charles Dodt, 1958, R.L.S. #2174,
Placed 2" iron pipe w/brass tablet 18" above ground.
N45°14'W 36.0' 5" W. Pine (R)
S63°39'W 51.8' 2" W. Pine (R)
S07°23'W 40.3' 9" Y. Pine (R)
S89°16'E 18.6' 8" W. Pine (R)

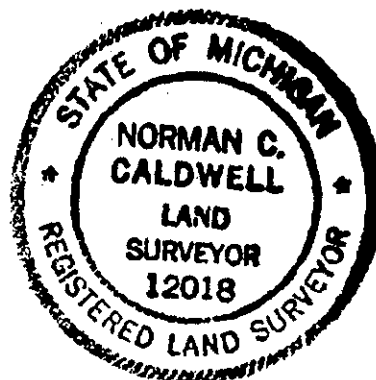

C. Description of monument for corner and accessories established to perpetuate locating the position of the corner:

A-8 W 1/4 cor., Sec. 19, T21N-R13W
Fnd. 2" O.D. galvanized pipe w/brass cap, 1.35' above ground
Charles Dodt, 1958, R.L.S. #2174. Accepted existing corner and is accepted as the best available evidence of the position of the original corner.
S47°E 21.65' 5" S. Maple
S05°W 69.22' 6" S. Maple
N88°W 63.14' 6" S. Maple
N49°E 8.95' 6" S. Maple
North 1.90' Cedar Post
East 1.0' Carsonite Witness Post

Corner H - E ratified by the Manistee County Peer Group pursuant to P.A. 123 of 1915, as amended by Act 123 of 1993

Signed by

Norman C. Caldwell

Date

12 JAN 93

Surveyor's Michigan License No.

12018