

APR 08 1996

LAND CORNER RECORDATION CERTIFICATE  
Filing Requirement of Act 74, Mich. P.A. 1970

ALS<sup>0</sup>  
D-13  
T22N  
R13W

COMMISSION

Located In: \_\_\_\_\_ Corner Code #/

Public Land Survey	T	21N	R	13W	(D-1)
Property Controlling	T		R		
Section	T		R		
Miscellaneous	T		R		
Property in Sec.	T		R		

REGISTER'S OFFICE  
MANISTEE COUNTY  
#93 303 Rt 1147 A.M.  
MAY 12 1993  
Penney G. Peck  
REGISTER OF DEEDS

Register of Deeds Stamp & File Number

Plat No. \_\_\_\_\_, Recorded Plat \_\_\_\_\_  
Private Claims \_\_\_\_\_

Norman C. Caldwell in a field survey on September 19 92

I hereby certify that under requirements of P.A. 74, Michigan P.A. of 1970, the corner points mentioned in lines 1 and 2 above were in conformance with regulations and rules therefore as required in the manual of survey instructions of the United States Department of the Interior, Bureau of Land Management or by a decree of a Court of Law and/or that the corner points mentioned in lines 3, 4 and 5 were in conformance with the rules of the Michigan Board of Land Surveyors or by a Decree of a Court of Law, established, re-established, monumented, re-monumented, recovered, found as recorded below:

Not more than 4 corners, all in the same town and range, may be recorded on this certificate.

A	B	C	D	E	F	G	H	I	J	K	L	M
2	6	5	4	3	2	1						
3												
4	7	8	9	10	11	12						
5												
6	18	17	16	15	14	13						
7												
8	19	20	21	22	23	24						
9												
10	30	29	28	27	26	25						
11												
12	31	32	33	34	35	36						
13												

Description of original monument and accessories and/or subsequent restoration.

Post Placed by John Brink, 1839  
N82°W 63 lks. (41.58') 10" ???  
N31°E 31 lks. (20.46') 8" Elm

D-1 Post Placed by John Brink, 1839  
N12½°E 37 lks. (24.42') 14" Beech  
N02°W 48 lks. (31.68') 8" Ironwood

Corner D-1  
County Pen...  
1515.05  
S...  
D-1

Description of corner evidence found and/or method applied in restoring or reestablishing corner.

Sec. cor., 5 & 6, T21N-R13W & Sec. 31 & 32, T22N-R13W D-1


Survey by Fargo Eng. Co. in August 1909. Fnd. one Cedar Witness for corner and one Cedar B.T. meander corner.  
S32°E 87 lks. (57.42') 16" Hemlock  
S39°W 87½ lks. (57.75') 12" Hemlock

Survey by George Blass in October, 1965, NE corner of Section 6 falls in water

Survey by William B. Batzer, Jr. in April 1967 - February 1970, NE corner of Section 6 falls in Tippy Backwater.

1/4 cor., Sec. 5, T21N-R13W & Sec. 32, T22N-R13W D-1

No Subsequent Record

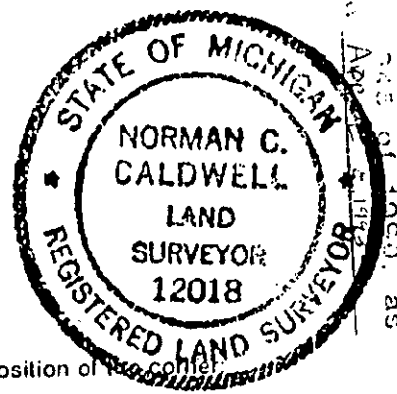

Description of monument for corner and accessories established to perpetuate localing the position of corner.

Sec. cor., 5 & 6, T21N-R13W & Sec. 31 & 32, T22N-R13W D-1

Position falls in back waters of Tippy Dam. No monument placed. Utilized record position and is accepted as a careful and faithful reestablishment of the position of the original corner, and established a reference monument on line between Sec. 5 & 6 at a distance of 394.55 feet South.  
South 291.05' 1x2" bar w/C.P. Co. cap (R)  
685.60

1/4 cor., Sec. 5, T21N-R13W & Sec. 32, T22N-R13W D-1

Position falls in back waters of Tippy Dam. No monument placed. Utilized record position by orig. govt. survey and Fargo Eng. Co. by single proportion between record position of N.E. Sec. 6, and recovered original N.E. Sec. 4, and is accepted as a careful and faithful reestablishment of the position of the original corner.

Norman C. Caldwell  
Surveyor's Michigan License No. 12018

Date 12 JAN 93