

LAND CORNER RECORDATION CERTIFICATE
Filing Requirement of Act 74, Mich. P.A. 1970

DEC 29 1996

COMMISSION REGISTER'S OFFICE MANISTEE COUNTY

#97-378 AT 10:40A.m.

OCT 14 1997

Permy a. Repore REGISTER OF DEEDS

Register of Deeds Stamp & File Number

Form with fields for 'For corners in Manistee (County)', 'Located In:', 'Corner Code #', and numbered sections 1-5 for survey details.

Grid table with columns A-M and rows 1-13, containing numbers 1-36.

I, Kenneth L. Ross, in a field survey on July 31 19 97, do hereby certify that under requirements of P.A. 74, Michigan P.A. of 1970, the corner points mentioned in lines 1 and 2 above were in conformance with regulations and rules therefore as required in the current manual of survey instructions of the United States Department of the Interior, Bureau of Land Management or by a decree of a Court of Law and/or that the corner points mentioned in lines 3, 4 and 5 above were in conformance with the rules of the Michigan Board of Land Surveyors or by a Decree of a Court of Law, established, re-established, monumented, re-monumented, recovered, found as expressed below.

NOTE: Not more than 4 corners, all in the same town and range, may be recorded on this certificate.

A. Description of original monument and accessories and/or subsequent restoration: F-13 South 1/4 Corner for Section 33, T21N-R13W.

1837, John Brink, G.L.O. Set Wood Post #1 White Oak 8" N 61° W 27 lks. (17.82') #2 White Oak 7" N 27° E 16 lks. (10.56')

1907, John Millard, Manistee Co. Surveyor Monument not given, recovered GLO Stake point & witness Trees #3 White Pine 36" S 05° W 23 lks. (15.18') #4 White Pine 30" N 23° W 41 lks. (27.06') Book "A" Page 17

1963, Robert A. Griffin, RLS #13584 Found remains of rotted wood stake and Millard witness stumps, and GLO witness Replaced wood stake w/ a 5" sq. x 5 foot long conc. Monument w/ 3" Brass Tablet #5 White Oak 6" N 61° E 33.95' #6 Red Oak 6" N 60° W 43.70' #7 Maple 3" N 10° W 31.10' #8 Cedar Post 6" North 1.4'

1992, Rowe Engineering, Norm Caldwell, RLS #12018 Used Griffin Monument in a Cadastral Survey for the U.S.F.S.

B. Description of corner evidence found and/or method applied in restoring or reestablishing corner: F-13 South 1/4 Corner for Section 33, T21N-R13W.

On July 31, 1997, I Kenneth Ross and Kevin Pritchard (survey tech.) found a 5" square concrete monument with a 3 1/4" brass cap, stamped to identify this corner, this corner is 35 feet North of the center-line of 12 Mile Road, 1 foot above to ground surface.


Condition of record witnesses are: #1 Gone #2 Gone #3 Found 40" Pine stump #4 Gone #5 Found in good condition #6 Found in good condition #7 Found in good condition #8 Found in poor condition

Corner F-13 ratified by the Manistee County Peer Group according to the county plan adopted pursuant to P.A. 345 of 1990, as amended, (being the State Survey and Remonument Act, MCL 54.261 et. seq.) Date of Peer Review: OCT 7 1997

C. Description of monument for corner and accessories established to perpetuate locating the position of the corner: F-13 South 1/4 Corner for Section 33, T21N-R13W.

I accepted Griffin's 5" concrete monument with 3 1/4" brass cap as a substantial marker for the corner and is accepted as a perpetuation of the position of the original corner.

(ext. BT) #5 White Oak 12" N 61° E 33.88' (10" dock spike in SE side of tree) (ext. BT) #6 Red Oak 13" N 60° W 43.35' (10" dock spike in SW side of tree) (ext. BT) #7 Maple 8" N 10° W 31.00' (10" dock spike in SW side of tree) (New BT) #9 Black Oak 13" S 19° W 8.49' (set 60d spike in NW side of tree)

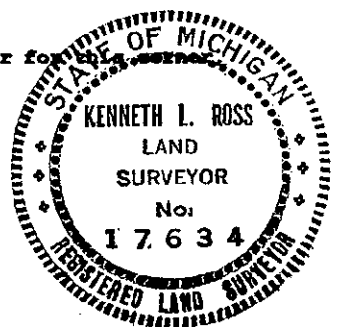

Signed by [Signature]

Date August 29 1997

Surveyor's Michigan License No. 17634