

1993

LAND CORNER RECORDATION CERTIFICATE
Filing Requirement of Act 74, Mich. P.A. 1970

COMMISSION

For corners in

Manistee

(County)

Located In:

Corner Code ##

- 1. Public Land Survey T 21N R 13W G-8, G-12
2. Property Controlling in Section S T R
3. Miscellaneous Property in Sec. S T R

REGISTER'S OFFICE
MANISTEE COUNTY

# 93-299 AT 11:30 a.m.

MAY 12 1993

Penny A. Popow
REGISTER OF DEEDS

Register of Deeds Stamp & File Number

- 4. Lot No. Recorded Plat
5. Private Claims

I, Norman C. Caldwell, in a field survey on September 19 92


do hereby certify that under requirements of P.A. 74, Michigan P.A. of 1970, the corner points mentioned in lines 1 and 2 above were in conformance with regulations and rules therefore as required in the current manual of survey instructions of the United States Department of the Interior, Bureau of Land Management or by a decree of a Court of Law and/or that the corner points mentioned in lines 3, 4 and 5 above were in conformance with the rules of the Michigan Board of Land Surveyors or by a Decree of a Court of Law; established, re-established, monumented, re-monumented, recovered, found as expressed below:

NOTE: Not more than 4 corners, all in the same town and range, may be recorded on this certificate.

Grid table with columns A-L and rows 2-13. Contains numerical data points for survey locations.

A. Description of original monument and accessories and/or subsequent restoration:

- G-8 Post Placed by John Brink, 1839 S63°E 21 lks. (13.86') 8" P. Pine S29°W 18 lks. (11.88') 9" P. Pine
G-12 10" W. Pine cor. tree by John Brink, 1839

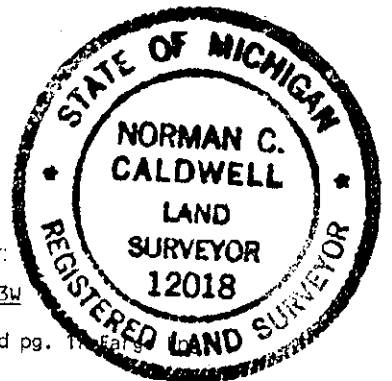

B. Description of corner evidence found and/or method applied in restoring or reestablishing corner:

- G-8 1/4 cor., Sec. 21 & 22, T21N-R13W Survey by Fargo Eng. Co. in July & Aug. 1909. Found stump of U.S. Y. Pine witness established/accepted position and set a typical "Fargo Monument".
G-12 1/4 cor., Sec. 33 & 34, T21N-R13W Manistee County Surveyors record pg. 1. No Monument Given. U.S. Forest Service land cor. record card Robert Griffin searched for the corner in 1963, and found nothing. Presumed it was a lost cor.

C. Description of monument for corner and accessories established to perpetuate locating the position of the corner:

- G-8 1/4 cor., Sec. 21 & 22, T21N-R13W At midpt. on line, Placed 2" iron pipe w/brass cap and is accepted as a careful and faithful reestablishment of the position of the original corner.
G-12 1/4 cor., Sec. 33 & 34, T21N-R13W At midpt. on line, Placed 2" iron pipe w/brass cap and is accepted as a careful and faithful reestablishment of the position of the original corner.

Corner G-8, G-12 ratified by the Manistee County Peer Group pursuant to P.A. 123 of 1915, as amended by P.A. 345 of 1990, as amended. Date of Peer Review: APRIL 1993

Signed by [Signature]
Surveyor's Michigan License No. 12018

Date 12 JAN 93