

1993
 COUNTY OF MANISTEE

LAND CORNER RECORDATION CERTIFICATE
 Filing Requirement of Act 74, Mich. P.A. 1970

For corners in
 Manistee

Located In: _____ Corner Code: ##

REGISTER'S OFFICE
 MANISTEE COUNTY
 #93-310 AT 1:23 P.M.
MAY 12 1993
Annex A Person
 REGISTER OF DEEDS

1. Public Land Survey	T	21N	R	13W	H-2, H-3
	T		R		
	T		R		
	T		R		
2. Property Controlling in Section	S		T	R	
	S		T	R	
3. Miscellaneous	S		T	R	
Property in Sec.	S		T	R	

Register of Deeds Stamp & File Number

4. Lot No. _____, Recorded Plat _____
 5. Private Claims _____

	A	B	C	D	E	F	G	H	I	J	K	L	M
2	6		5		4			●		2			
3								●					
4	7		8		9			10		11		12	
5													
6	18		17		16			15		14		13	
7													
8	19		20		21			22		23		24	
9													
10	30		29		28			27		26		25	
11													
12	31		32		33			34		35		36	
13													

I, Norman C. Caldwell in a field survey on September 1992
 do hereby certify that under requirements of P.A. 74, Michigan P.A. of 1970, the corner points mentioned in lines 1 and 2 above were in conformance with regulations and rules therefore as required in the current manual of survey instructions of the United States Department of the Interior, Bureau of Land Management or by a decree of a Court of Law and/or that the corner points mentioned in lines 3, 4 and 5 above were in conformance with the rules of the Michigan Board of Land Surveyors or by a Decree of a Court of Law, established, re-established, monumented, re-monumented, recovered, found as expressed below:

NOTE: Not more than 4 corners, all in the same town and range, may be recorded on this certificate.

A. Description of original monument and accessories and/or subsequent restoration:

H-2 This position not established by original government survey.
 H-3 Post Placed by John Brink, 1839
 S36°W 57 lks. (37.62') 10" W. Pine
 S61°E 75 lks. (49.50') 8" P. Pine


Corner H-02 ratified by the Manistee County Peer Group according to the county plan adopted pursuant to P.A. 345 of 1990, as amended, (being the State Survey and Remonument Act, MCL 54.261 et seq.). Date of Peer Review: OCT 3 1995

B. Description of corner evidence found and/or method applied in restoring or reestablishing corner:

H-2 C 1/4 cor., Sec. 3, T21N-R13W
 No Subsequent Record

H-3 1/4 cor., Sec. 3 & 10, T21N-R13W
 Survey by Fargo Engineering, Co. August 1909
 Fnd. both U.S. Witnesses
 S32½°E 0.77½ ch. (51.15') 15" W. Oak
 N81½°E 1.10 ch. (72.60') 6" B. Oak

County Surveyors Record by E. W. M. July 1914
 Mon. - Hyd. Co. Stake (Fargo)
 N69½°E 70½ lks. (46.53') 9" B. Oak
 S54½°E 51 lks. (33.66') 6" B. Oak

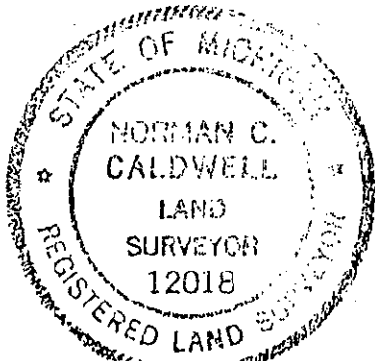

C. Description of monument for corner and accessories established to perpetuate locating the position of the corner:

H-2 C 1/4 cor., Sec. 3, T21N-R13W
At Inter. of 1/4 lines
 Placed 2" iron pipe w/brass cap. This position not established by original gov't survey. This monument is accepted as a careful and faithful determination of the position of the corner.
 N22°W 29.66' 12" W. Oak
 N62°E 32.19' 12" W. Pine
 S47°E 49.52' 12" B. Cherry
 S10°W 85.00' 10" W. Pine
 East 1.0' Carsonite Witness Post

H-3 1/4 cor., Sec. 3 & 10, T21N-R13W
 Fnd. record monument, replaced with 5" x 5" x 5" L. concrete monument w/brass tablet and is accepted as a careful and faithful perpetuation of the position of the original corner.
 N10°E 71.12' 5" W. Oak
 S29°E 36.93' 5" W. Oak
 N86°E 59.94' 10" W. Oak
 N69°W 35.45' 7" W. Pine
 S02°W 61.04' 3/4" Pipe #12018
 North 1.0' Carsonite Witness Post

County of Manistee, Michigan, amended by P.A. 123 of 1915, as amended by P.A. 345 of 1990, as amended. Date of Peer Review: APRIL 2 1993

Signed by Norman C. Caldwell

Date 12 JAN 93

Surveyor's Michigan License No. 12018