

LAND CORNER RECORDATION CERTIFICATE
Filing Requirement of Act 74, Mich. P.A. 1970

COMMISSIONER

For corners in
Manistee

Located In: Corner Code: H-2, H-3

REGISTER'S OFFICE
MANISTEE COUNTY

#93-310 AT 1:23 P.M.

MAY 12 1993

Penny A. P...
REGISTER OF DEEDS

Register of Deeds Stamp & File Number

- 1. Public Land Survey T 21N R 13W
- T _____ R _____
- T _____ R _____
- T _____ R _____
- 2. Property Controlling S _____ T _____ R _____
- in Section S _____ T _____ R _____
- 3. Miscellaneous S _____ T _____ R _____
- Property in Sec. S _____ T _____ R _____

- 4. Lot No. _____, Recorded Plat _____
- 5. Private Claims _____

Norman C. Caldwell September 19 92

I, _____ in a field survey on _____ do hereby certify that under requirements of P.A. 74, Michigan P.A. of 1970, the corner points mentioned in lines 1 and 2 above were in conformance with regulations and rules therefore as required in the current manual of survey instructions of the United States Department of the Interior, Bureau of Land Management or by a decree of a Court of Law and/or that the corner points mentioned in lines 3, 4 and 5 above were in conformance with the rules of the Michigan Board of Land Surveyors or by a Decree of a Court of Law; established, re-established, monumented, re-monumented, recovered, found as expressed below:

	A	B	C	D	E	F	G	H	I	J	K	L	M
2	6		5		4			●		2		1	
3								●					
4	7		8		9			10		11		12	
5													
6	18		17		16			15		14		13	
7													
8	19		20		21			22		23		24	
9													
10	30		29		28			27		26		25	
11													
12	31		32		33			34		35		36	
13													


NOTE: Not more than 4 corners, all in the same town and range, may be recorded on this certificate.

A. Description of original monument and accessories and/or subsequent restoration:

- H-2 This position not established by original government survey.
- H-3 Post Placed by John Brink, 1839
S36°W 57 lks. (37.62') 10" W. Pine
S61°E 75 lks. (49.50') 8" P. Pine

B. Description of corner evidence found and/or method applied in restoring or reestablishing corner:

- H-2 C 1/4 cor., Sec. 3, T21N-R13W
No Subsequent Record
- H-3 1/4 cor., Sec. 3 & 10, T21N-R13W
Survey by Fargo Engineering, Co. August 1909
Fnd. both U.S. Witnesses
S32½°E 0.77½ ch. (51.15') 15" W. Oak
N81½°E 1.10 ch. (72.60') 6" B. Oak
County Surveyors Record by E. W. M. July 1914
Mon. - Hyd. Co. Stake (Fargo)
N69½°E 70½ lks. (46.53') 9" B. Oak
S54½°E 51 lks. (33.66') 6" B. Oak

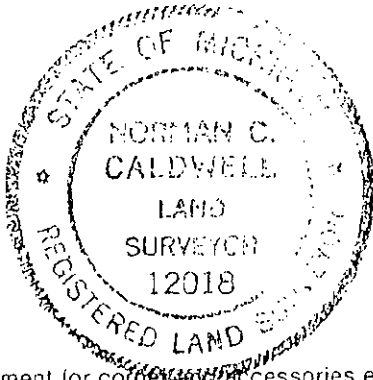

C. Description of monument for corners and accessories established to perpetuate locating the position of the corner:

- H-2 C 1/4 cor., Sec. 3, T21N-R13W
- H-3 1/4 cor., Sec. 3 & 10, T21N-R13W

County H-3
1915, as amended by P.A. 345 of
amended. Date of Peer Review: APR 12 1993