

APR 6 1996

LAND CORNER RECORDATION CERTIFICATE

Filing Requirement of Act 74, Mich. P.A. 1970

K-13 T22N R13W

For corners in


Manistee (County)

COMMISSION

Located In:

Corner Code #

1. Public Land Survey

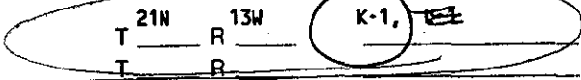

2. Property Controlling in Section

S T R

3. Miscellaneous Property in Sec.

S T R

REGISTER'S OFFICE MANISTEE COUNTY

#93-255 AT 9:58 A.M.

MAY - 7 1993

Penny A. Popera REGISTER OF DEEDS

Register of Deeds Stamp & File Number

4. Lot No. Recorded Plat 5. Private Claims


I, Norman C. Caldwell, in a field survey on September 19 92


do hereby certify that under requirements of P.A. 74, Michigan P.A. of 1970, the corner points mentioned in lines 1 and 2 above were in conformance with regulations and rules therefor as required in the current manual of survey instructions of the United States Department of the Interior, Bureau of Land Management or by a decree of a Court of Law and/or that the corner points mentioned in lines 3, 4 and 5 above were in conformance with the rules of the Michigan Board of Land Surveyors or by a Decree of a Court of Law; established, re-established, monumented, re-monumented, recovered, found as expressed below:

NOTE: Not more than 4 corners, all in the same town and range, may be recorded on this certificate.

A. Description of original monument and accessories and/or subsequent restoration:

K-1 Post placed by J. Brink, 1838 11" P. Pine N49°E 21 lks. (13.86') 10" P. Pine N35°W 37 lks. (24.42')

L-1 Post placed by J. Brink, 1838 12" W. Pine N 35 lks. (23.10') 16" W. Pine N23°W 14 lks. (9.24')

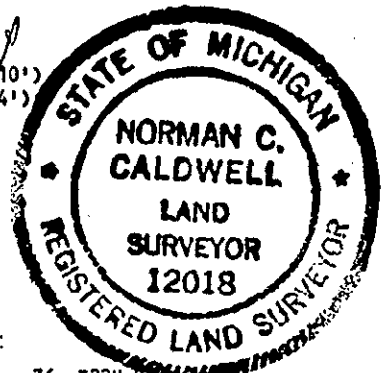

B. Description of corner evidence found and/or method applied in restoring or reestablishing corner:

K-1 Sec. cor., 1 & 2, T21N-R13W & 35 & 36, T22N-R13W Fargo, 1909 (Manistee County Surveyor's Record) Fnd. Stake N25°W 0.17% ch. (11.55') 12" W. Pine stp. S85°E 0.17% ch. (11.39') 12" W. Pine stp. S45°W 0.28% ch. (18.81') 6" W. Pine stp.

L-1 1/4 cor., Sec. 1, T21N-R13W & Sec. 36, T22N-R13W U.S.F.S. record 1984 by Robert Griffin Searched, fnd no evidence of corner. Established new position by prop. measure and on a straight line b/w controlling cor. Set 5" x 60" conc. monument w/brass cap S62°E 68.38' 10" DS on N side of 8" W. Pine S62°W 48.05' 10" DS on SE side of 8" W. Pine East 1.6' Iron fence post N34°W 74.86' 10" DS on SW side 16" W. Oak

County Surveyor's Record 1909 by D. Skeels Monument - Not Given N13°E 12' 15" Pitch Pine stp. West 19' 79" Pitch Pine stp.

Survey by Clinton Cole, 1983 Fnd. Iron Pin per Liber 84, page 3 N64°E 24.11' 12" W. Pine N33°W 23.36' 6" W. Pine S7°E 68.60' 6" Maple

C. Description of monument for corner and accessories established to perpetuate locating the position of the corner:

K-1 Sec. cor., 1 & 2, T21N-R13W & 35 & 36, T22N-R13W Fnd. 1" hex bar per L. 84, pg. 3, replaced with 2" galv. pipe w/brass cap .3' above ground and is accepted as a careful and faithful reestablishment of the position of the original corner. S13°E 68.60' 6" Red Maple (R) S37°W 54.58' 5" White Pine N42°W 23.35' 7" W. Pine (R) N60°E 24.15' 14" W. Pine (R) South 1.0' Carsonite Witness Post

L-1 1/4 cor., Sec. 1, T21N-R13W & Sec. 36, T22N-R13W Fnd. 5" x 5" conc. post w/brass tablet 18" above ground per U.S.F.S. record in Sec. 36, T22N-R13W and is accepted as the best available evidence of the position of the position of the original corner. S01°W 29.49' 7" W. Pine S61°W 48.08' 7" W. Pine N38°W 74.86' 14" White Oak (R) S68°E 68.38' 8" W. Pine (R) East 1.0' Carsonite Witness Post

Corner K-15 County Peer Group 1915, as amended by P.A. 345 of 1990, as amended. Date of Peer Review: APRIL 8, 1993

Signed by Norman C. Caldwell

Date 12 JAN 93

Surveyor's Michigan License No. 12018