

DEC 23 1997

AND CORNER RECORDATION CERTIFICATE
Filing Requirement of Act 74, Mich. P.A. 1970

SECTION

For corners in Manistee (County) Located In: Corner Code #
1. Public Land Survey T 21N R 13W K-13
2. Property Controlling in section S T R
3. Miscellaneous Property in Sec. S T R

REGISTER'S OFFICE
MANISTEE COUNTY
98-273 at 3:20pm
JUL 07 1998
Deborah Six
REGISTER OF DEEDS

Register of Deeds Stamp & File Number

4. Lot No. Recorded Plat
5. Private Claims

Grid table with columns A-M and rows 1-13. Contains numbers 1-36 in a grid pattern.

I, Kenneth L. Ross, in a field survey on June 8 1998, do hereby certify that under requirements of P.A. 74, Michigan P.A. of 1970, the corner points mentioned in lines 1 and 2 above were in conformance with regulations and rules therefore as required in the current manual of survey instructions of the United States Department of the Interior, Bureau of Land Management or by a decree of a Court of Law and/or that the corner points mentioned in lines 3, 4 and 5 above were in conformance with the rules of the Michigan Board of Land Surveyors or by a Decree of a Court of Law, established, re-established, monumented, re-monumented, recovered, found as expressed below.

NOTE: Not more than 4 corners, all in the same town and range, may be recorded on this certificate.

A. Description of original monument and accessories and/or subsequent restoration:
K-13 Section Corner for Sections 35 and 36, on the Township-line, T21N-R13W.

1839, John Brink, G.L.O., Boundary Survey
Set Wood Post
#1 White Oak 10" N 88-1/2" E 21 lks. (13.86')
#2 White Oak 10" S 85 E 205 lks. (135.3')

1963, Robert A. Griffin
Found old rust marks in the intersection of east-west road and road to the north, also found Millard's witness trees, in good cond. Set a 5" square concrete monument, 36" long, with a 3" brass cap, stamped to identify the corner, set in the exact location of rust in sand. (Liber 75, Page 76)

1907, John H. Millard, M.C.S.
monument not given
#3 Black Oak 10" N 40 E 64 lks. (42.24')
#4 Black Oak (no size) N 20 W 78 lks. (51.48') (Book "A" Page 14)

#5 Iron Pipe 1" x 30" N 40 E 88.20' (in old N-S fence)
#6 White Oak 6" N 58 W 139.75' (10" dock spk.
#7 Black Oak 25" N 42 E 42.80' (center of tree)
#8 Black Oak 23" N 20 W 52.00' (center of tree)
#9 Cedar Post 6" x 7' N 45 W 46.7'

1993, Nora Caldwell, RLS#12018
Used Griffin monument in cadastral Survey (#3) for the U.S.F.S., no new witness were taken (#4)

B. Description of corner evidence found and/or method applied in restoring or reestablishing corner:
K-13 Section Corner for Sections 35 and 36, on the Township-line, T21N-R13W.

On June 8, 1998, I found 5" square concrete monument placed by Griffin in 1963. Monument sets 4 feet South of the C-L of 12 mile and the C-L of Chalker Road, one foot below road surface. I search but found no evidence to dispute this location for the corner.

Condition of record witnesses are as follows: #1 Gone #2 Gone #3 Gone #4 Gone

#5 Found in good condition #6 Found in good condition #7 Gone #8 Same as #4 #9 Gone

FD #10 & 11 with No history.

#8 is Gone

C. Description of monument for corner and accessories established to perpetuate locating the position of the corner:
K-13 Section Corner for Sections 35 and 36, on the Township-line, T21N-R13W.


I accepted Griffin's 5" square by 36" long, concrete monument with 3 1/2" brass cap, stamped to identify the corner as a substantial marker for the corner and is accepted and a careful and faithful re-establishment of the position of the original corner.

Ext. "BT" #5 Iron Pipe 1" x 30" N 40 E 88.20' (in old N-S fence)
Ext. "BT" #6 White Oak 6" N 58 W 139.75' (10" dock in SW side tree)
Ext. "BT" #10 White Oak 16" N 45 W 70.11' (fd. 60d spike in NE side of tree)
Ext. "BT" #11 Black Oak Triple 10"-16"-17" S 68 W 44.01' (fd. 60d spike in NW side of tree)

Signed by [Signature]

Date July 2, 1998

Surveyor's Michigan License No. 17634

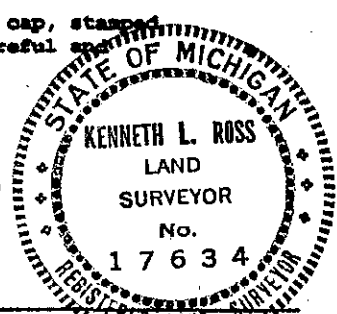

Corner K-13 ratified by the Manistee County Peer Group according to the county plan adopted pursuant to P.A. 345 of 1990, as amended, (being the State Survey and Remonument Act, MCL 54.261 et. seq.). Date of Peer Review: July 7 1998 Anthony M. Stawski