

SURVEY
REMON

MAY 1 1996

LAND CORNER RECORDATION CERTIFICATE
Filing Requirement of Act 74, Mich. P.A. 1970

For corners in MANISTEE Located in: _____ Corner Code # _____
(County)

1. Public Land Survey T 21N R 13W M-13
T _____ R _____
T _____ R _____
T _____ R _____

2. Property Controlling S _____ T _____ R _____
In Section S _____ T _____ R _____

3. Miscellaneous S _____ T _____ R _____
Property in Sec. S _____ T _____ R _____

4. Lot No. _____ Recorded Plat _____

5. Private Claims _____

REGISTER'S OFFICE
MANISTEE COUNTY
#96-372 AT 11:35 A.M.
AUG 23 1996
Benny A. Pepera
REGISTER OF DEEDS
Register of Deeds Stamp & File Number

I, Kenneth L. Ross, in a field survey on July 17, 1996, do hereby certify that under requirements of P.A. 74, Michigan P.A. of 1970, the corner points mentioned in lines 1 and 2 above were in conformance with regulations and rules therefore as required in the current manual of survey instructions of the United States Department of the Interior, Bureau of Land Management or by a decree of a Court of Law and/or that the corner points mentioned in lines 3, 4 and 5 above were in conformance with the rules of the Michigan Board of Land Surveyors or by a Decree of a Court of Law, established, re-established, monumented, re-monumented, recovered, found as expressed below.

NOTE: Not more than 4 corners, all in the same town and range, may be recorded on this certificate.

A. Description of original monument and accessories and/or subsequent restoration:

- M-13 Sec. Cor., 36-21-13
1839 John Brink
(1) 16" B. Oak N 14.5 E 413 lks
(2) 4" P. Pine S 10 W 270 lks

B. Description of corner evidence found and/or method applied in restoring or reestablishing corner:

- M-13 Sec. Cor., 36-21-13
July, 1909, Fargo Eng. Co. Fd. probable roots of GLO witness (Book A, Page 14)
(3) 8" B. Oak S 57 W 16 lks
(4) 7" B. Oak N 15 W 10 lks
(5) 6" W. Oak S 50 E 30 lks
Sep., 1963, Robert Griffin Fd. remains of rotted wood post and sprouts from #3 & 4, replaced with 5" x 5' Square Reinforced Concrete Post set 1.5' above ground and filed Act 74 (June 1973) Liber 73, Page 66
(6) 10" dock spike in 7" B. Oak (scribed BT) N 10 E 5.45'
(7) 10" dock spike in 5" W. Oak (scribed BT) N 50 E 141.40'
(8) 10" dock spike in 6" B. Oak (scribed BT) N 40 W 63.65'
(9) 6" x 7' Cedar Post North 2.7'
(10) CL earth road east South 36'
(11) Fence corner (fence N&E) N 67 E 165.90'
Aug., 1992, Norman Caldwell for USDA Forest Service Fd. 5" Square Concrete Post per Liber 73, Page 66
same witness as #6, 7, 8, 9, 10, & 11
Oct., 1993, Pullen Fd. 5" x 60" Concrete Monument and 3 of 4 Griffin witness intact same witness as #6, 7, 8, 9, and
(12) 6" B. Oak S 22 W 32.94' (Liber 4, Page 157 Wexford County)
July, 1996, K. Ross Fd. 5" x 5' Square Reinforced Concrete Post as set by Griffin, Road NW-SE North 105'


C. Description of monument for corner and accessories established to perpetuate locating the position of the corner:

- M-13 Sec. Cor., 36-21-13
Fd. Witness #6 (now 16"), 7 (now 10"), 8 (now 11"), 9, 11 (trace old fence), & 12 (now 11")
Witness #1, 2, 3, 4, & 5 gone. There is no Rd. to East, #10 may be incorrect.
Left 5" x 5' Square Reinforced Concrete Post in place, and is accepted as the best available evidence of the original corner.
(13) 7" B. Oak S 27 W 32.89' (Spike)

	A	B	C	D	E	F	G	H	I	J	K	L	M
2	6	5	4	3	2	1							
3													
4	7	8	9	10	11	12							
5													
6	18	17	16	15	14	13							
7													
8	19	20	21	22	23	24							
9													
10	30	29	28	27	26	25							
11													
12	31	32	33	34	35	36							
13													

Signed by [Signature] Date 8-5-96

Surveyor's Michigan License No. 17634

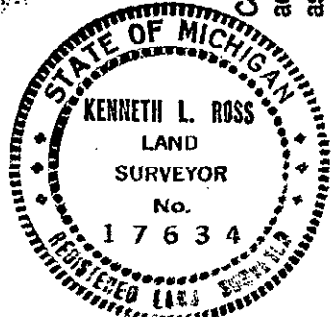

ratified by the Manistee County Peer Group according to the county plan adopted pursuant to P.A. 345 of 1990, as amended, (being the State Survey and Monument Act, MCL 54.261 et seq.) - Date of Peer Review AUG 6 1996
Anthony M. Hainishi