

1993

LAND CORNER RECORDATION CERTIFICATE  
Filing Requirement of Act 74, Mich. P.A. 1970

COMMISSION

For corners in  
Manistee

(County)

Located In:

Corner Code #

REGISTER'S OFFICE  
MANISTEE COUNTY

# 93-308 AT 11:59 A.M.

MAY 12 1993

*Penny A. Pevora*  
REGISTER OF DEEDS

Register of Deeds Stamp & File Number

- 1. Public Land Survey T \_\_\_ R \_\_\_
- 2. Property Controlling in Section S 4 T 21N R 13W
- 3. Miscellaneous S \_\_\_ T \_\_\_ R \_\_\_
- Property in Sec. S \_\_\_ T \_\_\_ R \_\_\_


*Other #2*  
*4-14, 4-15.5*

- 4. Lot No. \_\_\_\_\_, Recorded Plat \_\_\_\_\_
- 5. Private Claims \_\_\_\_\_

I, Norman C. Caldwell, in a field survey on September, 19 92

do hereby certify that under requirements of P.A. 74, Michigan P.A. of 1970, the corner points mentioned in lines 1 and 2 above were in conformance with regulations and rules therefore as required in the current manual of survey instructions of the United States Department of the Interior, Bureau of Land Management or by a decree of a Court of Law and/or that the corner points mentioned in lines 3, 4 and 5 above were in conformance with the rules of the Michigan Board of Land Surveyors or by a Decree of a Court of Law; established, re-established, monumented, re-monumented, recovered, found as expressed below:

INDIAN RESERVE

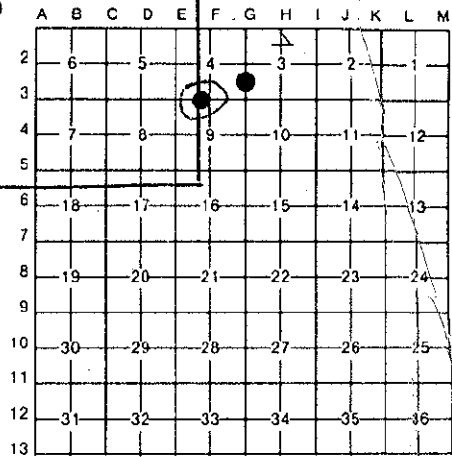

NOTE: Not more than 4 corners, all in the same town and range, may be recorded on this certificate.

A. Description of original monument and accessories and/or subsequent restoration:


4-14 This position not established by original government survey. 4-15.5 Post Placed by John Brink, 1837  
N75°W 23 lks. (15.2') 12" W. Pine  
S65°W 11 lks. (7.3') 24" W. Pine

B. Description of corner evidence found and/or method applied in restoring or reestablishing corner:

4-14 S 1/16 cor., Sec. 3 & 4, T21N-R13W 4-15.5 I.R. Boundary, Sec. 4 & 9, T21N-R13W  
No Subsequent Record No Subsequent Record

C. Description of monument for corner and accessories established to perpetuate locating the position of the corner:

4-14	<u>S 1/16 cor., Sec. 3 &amp; 4, T21N-R13W</u>	<u>4-15.5</u>	<u>I.R. Boundary, Sec. 4 &amp; 9, T21N-R13W</u>
	Placed 5/8" iron rod w/alum. cap. This position not established by original gov't survey. This monument is accepted as a careful and faithful determination of the position of the corner.		Placed 2" iron pipe w/brass cap and is accepted as a careful and faithful reestablishment of the position of the corner.
	N60°E 11.80' 8" Hemlock		S66°W 45.87' P.L.P.
	S07°W 24.24' 7" Hemlock		N07°W 35.57' 10" W. Oak
	S87°W 42.53' 8" Hemlock		S54°E 95.13' 16" W. Oak
	N46°W 48.17' 8" Hemlock		N51°E 33.73' 12" Twin W. Oak
	East 1.0' Carsonite Witness Post		West 1.0' Carsonite Witness Post
			East 319.75' 5/8" x 24" rerod w/alum. cap

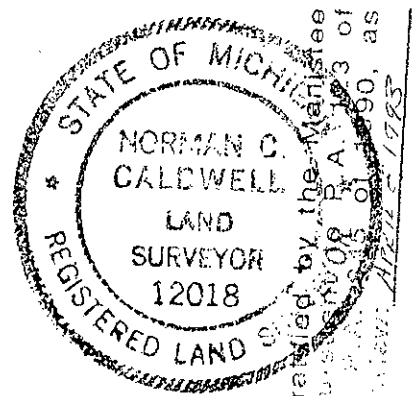

Corner 4-15.5 established by the Manistee County Peer Group pursuant to Act 193 of 1915, as amended, effective January 1, 1990, as amended. Date of Peer Review: April 5, 1993

Signed by *Norman C. Caldwell*  
Surveyor's Michigan License No. 12018

Date 12 JAN 93