

REN

9/23/99

301

MAY 13 2000

"K"

LAND CORNER RECORDATION CERTIFICATE  
Filing Requirement of Act 74, Mich. P.A. 1970

SECTION

For corners in


| Manistee<br>(County)               | Located In:  | Corner Code #                             |
|------------------------------------|--|---|
| 1. Public Land Survey              | T 22N R 15W<br>T 22N R 14W<br>T 21N R 14W<br>T 21N R 15W | M-13 SE Sec. 36<br>A-13<br>A-01 ✓<br>M-01 |
| 2. Property Controlling in Section | S _____ T _____ R _____                                  | _____                                     |
| 3. Miscellaneous Property in Sec.  | S _____ T _____ R _____                                  | _____                                     |

REGISTER'S OFFICE  
MANISTEE COUNTY

99-335 at 4:45pm  
SEP 29 1999

Deborah Six  
REGISTER OF DEEDS

Register of Deeds Stamp & File Number

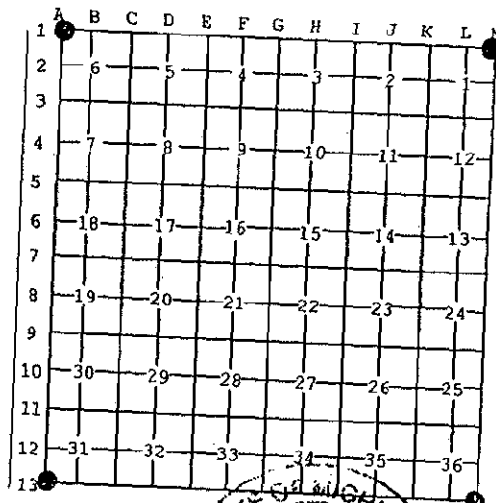

I, Bruce J. Jenema, in a field survey on August 31, 1999 do hereby state that under requirements of P.A. 74, Michigan P.A. of 1970, the corner points mentioned in lines 1 and 2 above were in conformance with regulations and rules therefore as required in the current manual of survey instructions of the United States Department of the Interior, Bureau of Land Management or by a decree of a Court of Law and /or that the corner points mentioned in lines 3, 4 and 5 above were in conformance with the rules of the Michigan Board of Land Surveyors or by a Decree of a Court of Law; established, reestablished, monumented, recovered, found as expressed below:

A. Description of original monument and accessories and/or subsequent restoration:

1837 J. Brink, D.S., G.L.O.

Set post

- 1.) Beech 13" N84°E 7 lks (7.66')
- 2.) Beech 11" N83 1/2°W 25 lks (16.50')

1959 Charles Dodt

Unrecorded survey

Found Iron pipe

- 8.) Oak 20" S5°W 64'
- 9.) Oak 18" N20°E (Distance illegible)

1972 R.H. Kraft

Unrecorded survey Job. No. 220-71

Found 1" pipe

- 10.) 7" Tw. Maple NE 66.59'
- 11.) 9" W. Pine SE 66.93'
- 12.) 16" W. Oak SSW 52.10'

1990 Ken L. Ross

Recorded Liber 2 of surveys page 176

Found U.S.F.S. Concrete monument

1907 J.H. Millard

Recorded C.S. Book A. pgs 38, 131 & 118

No U.S. Witnesses


- 3.) W. Pine Stump 18" N 1/1/2°E 18 lks (11.88')
- 4.) W. Pine Stump 16" S54 1/2°E 82 lks (54.12')
- 5.) Y. Pine stump 10" N77°W 24 lks (15.84')
- 1914 Fargo No Government witnesses
- 6.) Y. Pine stump 10" N30°W 24 1/2 lks (16.17')
- 7.) W. Pine stump 10" S54 1/2°E 82 lks (54.12')

1980 G.A. Fauser Consumers Power Co.

Recorded Liber 1 of surveys page 809

Found pipe with brass cap

- 12.) 17" Oak S9°W 52.14'
- 13.) 7" Pine S18°E 60.75' found
- 14.) 8" Pine S40°W 56.00'
- 15.) 12" Oak S43°E 79.17'
- USFS ID South 33.86'

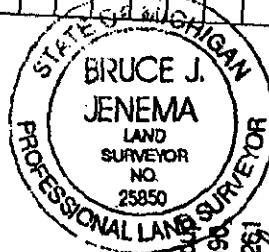

ratified by the Manistee County Peer Group pursuant to P.A. 345 of 1996 as amended, (being the State Survey and Remonument Act, MCL 54.261 et. seq.). Date of Peer Review: Sept 7, 1999

B. Description of corner evidence found and/or method applied in restoring or reestablishing corner:

On Sept. 3, 1999, I found a standard US Forest Service concrete monument and brass cap. No conflicting evidence of other corners existing.

Witnesses 1.) 2.) 3.) 4.) 5.) 6.) 7.) 8.) 9.) 10.) 14.) are extinct

Witness # 11.) & 15.) no marks on tree

Witness # 12 stump in poor condition Fd 60-D E. Side

C. Description of monument for corner and accessories established to perpetuate locating the position of the corner:

On Sept 3, 1999, I found a 6" round concrete monument with a 3" brass cap stamped to identify the corner as a substantial marker for the corner and is also accepted as a careful and faithful reestablishment of the position of the original corner and witnessed by:

- 13.) 12" W. Pine S18°E 60.77' Fd. 80-D spike E. Side
- 16.) 8" W. Pine N60°E 65.45' Set 60-D spike W. side
- 17.) 4" concrete monument North 33.06' Ross ID cap
- 18.) 12" W. Pine S05°E Set 60-D E. side
- 19.) 18" W. Pine S50°E 58.35' Set 60-D E. side
- 20.) USFS ID post South 33.86' #16 nail E. side

Signed by Bruce J. Jenema  
Surveyor's Michigan License No. 25850

Date 9-16-99