

LAND CORNER RECORDATION CERTIFICATE

FILING REQUIREMENT OF ACT 74, MICH. P.A.1970

FOR CORNERS OF--:	LOCATED IN--:	CORNER CODE NUMBER
1. PUBLIC LAND SURVEY _____	21N N. 14W S., R. E. _____	C9
2. PROPERTY CONTROLLING IN SECTION _____	T. _____ N. S., R. E. _____	_____
3. MISCELLANEOUS PROPERTY IN SECTION _____	T. _____ N. S., R. E. _____	_____
4. LOT NO. _____, RECORDED PLAT _____		
5. PRIVATE CLAIMS _____		

REGISTER'S OFFICE
MANISTEE COUNTY
#93-213 AT 11:35
APR 20 1993
Penny A. Payne
REGISTER OF DEEDS

REGISTER OF DEEDS STAMP AND FILING NUMBER

I, Patrick R. Leemon do hereby certify that under requirements of P.A. 74, Michigan P.A. of 1970 the corner points mentioned in lines 1 and 2 above (identified with circles on index code diagram—over) were, in a field survey on January 23 1993, established, re-established, monumented, re-monumented, recovered, restored as expressed below and in conformance with regulations and rules therefore as required in the current manual of survey instructions of the United States Department of the Interior, Bureau of Land Management or by a decree of court of law. Furthermore, that the corner points mentioned in lines 3, 4 and 5 above were, in a field survey on _____ 19____, found, recovered, restored, established or re-established as expressed below and in conformance with the rules of the Michigan State Board of Registration for Land Surveyors or, by a Decree of a Court of law:

A. Description of original monument and accessories and/or subsequent restoration:

Section Corner common to sec's. 19, 20, 29 and 30 of T21N R14W
1978 Survey by Robert A. Griffin
Monu. Set 5" sq. by 60" long concrete monu. with 3" brass disk.
Witnesses
R.Oak 14 N42W 45.39'
J.Pine 10 N57E 31.53'
J.Pine 4 S47E 26.89'
Pine Post 4 South 2.03'

B. Description of corner evidence found and/or method applied in restoring or re-establishing corner:

I found the monument and all the witnesses except the J.Pine S47E which is dead, to be in good condition. The monument extends 1.2' above the surface. Liber 79 Page 8 documents the history of this corner as perpetuated by Griffin. I could find no evidence of the 1838 GLO post or witnesses. Slawinski has measurements of N2-50-49W 2637.70' to the W1/4 of 20 and S89-50-44E 2651.38' to the S1/4 of 20. A 1992 survey by Caldwell retraced the south line of 20 and is in agreement with Slawinski's distance. There are no GLO calls within 34 chains to confirm this position. I accept this position as the best available evidence.

C. Description of monument for corner and accessories established to perpetuate locating the position of corner:

Section Corner common to sec's. 19, 20, 29 and 30 of T21N R14W
Monu. 5" sq. by 60" long concrete monu. with 3" brass disk.
Witnesses
R.Oak 14 N42W 45.39'
J.Pine 10 N57E 31.53'
B.Oak 4 S25E 42.61'
Pine Post 4 South 2.03'
J.Pine 8 S50W 31.92'
Iron Pipe 1 1/2" N51W 8.8'
Centerline of road to 2-track to north is East 9'
Corner is approximately 130' SW of a cement block cabin

Corner C-9 ratified by the Manistee County Peer Group pursuant to P.A. 123 of 1970, as amended by P.A. 345 of 1990, as amended. Date of Peer Review: FEB 11 1993

SURVEY & REMONUMENTATION

1993
COMMISSION


SIGNED BY Patrick R. Leemon DATE January 25, 1993

SURVEYOR'S MICHIGAN REGISTRATION NO. 31595

FOR STATE AND UNITED STATES AGENCIES:

SIGNED BY _____ DATE _____
CHIEF OF SURVEY PARTY

APPROVED AND SIGNED BY _____
MICHIGAN REGISTERED LAND SURVEYOR

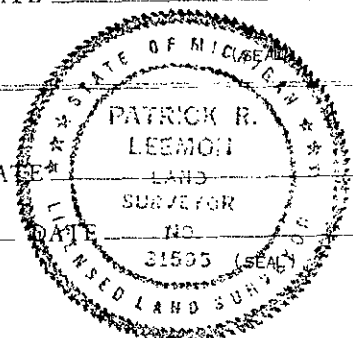

SURVEYOR'S MICHIGAN REGISTRATION NO. _____