

LAND CORNER RECORDATION CERTIFICATE
Filing Requirement of Act 74, Mich. P.A. 1970

For corners in

<u>MANISTEE</u> <small>(County)</small>	Located In:	Corner Code -#
1. Public Land Survey	T <u>21N</u> R <u>14W</u>	C-13 <u>D-9</u>
	T _____ R _____	_____
	T _____ R _____	_____
2. Property Controlling in Section	S _____ T _____ R _____	_____
	S _____ T _____ R _____	_____
3. Miscellaneous Property in Sec.	S _____ T _____ R _____	_____
	S _____ T _____ R _____	_____

REGISTER'S OFFICE
 MANISTEE COUNTY
 #93-572 AT 4:25 p.m.
OCT 5 1993
Penny A. Repro
 REGISTER OF DEEDS

Register of Deeds Stamp & File Number

4. Lot No. _____, Recorded Plat _____
 5. Private Claims _____

A	B	C	D	E	F	G	H	I	J	K	L	M
2	6	5	4	3	2	1						
3												
4	7	8	9	10	11	12						
5												
6	10	17	16	15	14	13						
7												
8	19	20	21	22	23	24						
9												
10	30	29	28	27	26	25						
11												
12	31	32	33	34	35	36						
13												

I, Norman C. Caldwell, in a field survey on November, 1991, do hereby certify that under requirements of P.A. 74, Michigan P.A. of 1970, the corner points mentioned in lines 1 and 2 above were in conformance with regulations and rules therefore as required in the current manual of survey instructions of the United States Department of the Interior, Bureau of Land Management or by a decree of a Court of Law and/or that the corner points mentioned in lines 3, 4 and 5 above were in conformance with the rules of the Michigan Board of Land Surveyors or by a Decree of a Court of Law; established, re-established, monumented, re-monumented, recovered, found as expressed below.

NOTE: Not more than 4 corners, all in the same town and range, may be recorded on this certificate.


A. Description of original monument and accessories and/or subsequent restoration:

C-13 <u>Meander cor., 32, 21/14W</u>	<u>D-9</u>	<u>1/4 cor., Sec. 20 & 29</u>
Post placed by John Brink in 1842, township line survey. N23°W 36 lks. (23.76') 6" White Pine S41°E 34 lks. (22.44') 7" White Pine		Post placed by John Brink in 1830 subdivision survey. N07°E 36 lks. (23.76') 10" White Pine S70°E 34 lks. (22.44') 7" Aspen

B. Description of corner evidence found and/or method applied in restoring or reestablishing corner:

C-13 <u>Meander cor., 32, 21/14W</u>	<u>D-9</u>	<u>1/4 cor., Sec. 20 & 29</u>
Found 1 1/2" iron pipe & cedar post scribed M.C., by Ted Weirner as a meander corner on the 2nd correction line.		Anthony Slawinski placed 1 1/2" pipe by single proportion methods (1976±). No references found of record

NOTE: Corner recovery by John Bueche, reviewed by Harold Bruning, monumentation by Sam Barnett.

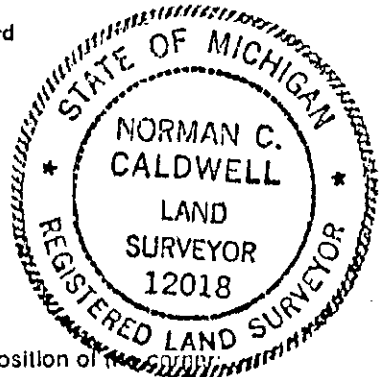

C. Description of monument for corner and accessories established to perpetuate locating the position of the corner:

C-13 <u>Meander cor., 32, T21N-R14W</u>	<u>D-9</u>	<u>1/4 cor., Sec. 20 & 29, T21N-R14W</u>
Found 1 1/2" iron pipe and placed 4' x 5/8" rerod w/alum. cap, inside existing 1 1/2" pipe, #16923, and is accepted as a careful and faithful perpetuation of the position of the original corner. S88°E 29.31' 6" Maple S36°E 9.29' 3" Black Ash N46°E 12.12' 10" Cedar West 30.0' East shore line West .3' Carsonite Witness Post		Found 1 1/2" pipe by Slawinski, and replaced with 5" x 5" x 36" conc. monument and is accepted as a careful and faithful reestablishment of the position of the original corner. N10°W 46.72' 15" Black Oak N38°W 25.60' 8" White Pine S72°W 44.76' 10" Sugar Maple S32°E 26.27' 16" Black Oak

Signed by *Norman C. Caldwell* Date 23 AUG 1993
Sam Barnett 10 JAN 1992

Surveyor's Michigan License No. 12018
 Corner C-13 MC ratified by the Manistee County Peer Group pursuant to P.A. 123 of 1915, as amended by P.A. 345 of 1990, as amended. Date of Peer Review: AUGUST 2 1993
 Corner D-9 ratified by the Manistee County Peer Group pursuant to P.A. 123 of 1915, as amended by P.A. 345 of 1990, as amended. Date of Peer Review: MAY 3 1993