

**LAND CORNER RECORDATION CERTIFICATE**  
Filing Requirement of Act 74, Mich. P.A. 1970

For corners in

<u>MANISTEE</u> (County)	Located In:	Corner Code #/
1. Public Land Survey	T 21N R 14W	<u>E-9</u> , E-10
	T _____ R _____	_____
	T _____ R _____	_____
2. Property Controlling in Section	S _____ T _____ R _____	_____
	S _____ T _____ R _____	_____
3. Miscellaneous Property in Sec.	S _____ T _____ R _____	_____
	S _____ T _____ R _____	_____

REGISTER'S OFFICE  
MANISTEE COUNTY  
#93-573 AT 4:30 p.m.  
OCT 5 1993  
*Penny A. Papan*  
REGISTER OF DEEDS

Register of Deeds Stamp & File Number

4. Lot No. \_\_\_\_\_, Recorded Plat \_\_\_\_\_  
5. Private Claims \_\_\_\_\_

A	B	C	D	E	F	G	H	I	J	K	L
2	6	5	4	3	2						
3											
4	7	8	9	10	11	12					
5											
6	18	17	16	15	14	13					
7											
8	19	20	21	22	23	24					
9											
10	30	29	28	27	26	25					
11											
12	31	32	33	34	35	36					
13											

I, Norman C. Caldwell, in a field survey on November, 1991, do hereby certify that under requirements of P.A. 74, Michigan P.A. of 1970, the corner points mentioned in lines 1 and 2 above were in conformance with regulations and rules therefore as required in the current manual of survey instructions of the United States Department of the Interior, Bureau of Land Management or by a decree of a Court of Law and/or that the corner points mentioned in lines 3, 4 and 5 above were in conformance with the rules of the Michigan Board of Land Surveyors or by a Decree of a Court of Law; established, re-established, monumented, re-monumented, recovered, found as expressed below:


**NOTE: Not more than 4 corners, all in the same town and range, may be recorded on this certificate.**

A. Description of original monument and accessories and/or subsequent restoration:

<u>E-9</u> Sec. cor., 20, 21, 28 & 29	E-10 1/4 cor., Sec. 28 & 29
Post placed by John Brink in subdivision survey November 25, 1838. S05°E 28 lks. (18.48') 10" Sugar Maple N77°W 18 lks. (11.88') 9" Hemlock	A 10" Black Ash marked for the corner by John Brink in 1838 subdivision survey. November 25, 1838. No References

B. Description of corner evidence found and/or method applied in restoring or reestablishing corner:

<u>E-9</u> Sec. cor., 20, 21, 28 & 29	E-10 1/4 cor., Sec. 28 & 29
Anthony Slawinski placed 1/4" pipe by record measure from East (2668.8') & North (2755.0') (Manistee Co. Surveyors Record) 1976±. NOTE: The dimension northerly to record existing 1/4 cor. 20 & 21 is substantially in excess of original dimension of 2640' & short in measure South to sec. cor. 28, 29, 32 & 33 (5145' vs. 5280') our research indicates substantial surveying activity & establishment of occupation lines in both Sec. 20 & 21, & dating from the late 1800's. Dimensions between verified government cor. in this township have been frnd. to be quite erratic, therefore, this position is accepted as the best available evidence of the position of the original corner.	No Subsequent Record

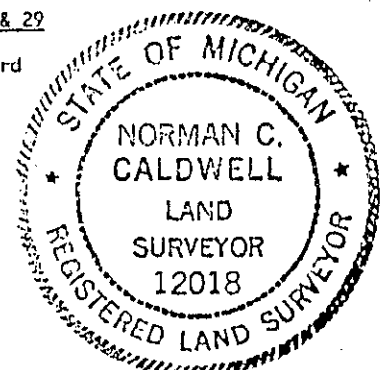

C. Description of monument for corner and accessories established to perpetuate locating the position of the corner:

<u>E-9</u> Sec. cor., 20, 21, 28 & 29, T21N-R14W	E-10 1/4 cor., Sec. 28 & 29, T21N-R14W
Found 1/4" pipe by Slawinski and replaced with 5" x 5" x 60" concrete monument in Beaver Pond and is accepted as the best available evidence of the position of the original corner. S05°E 68.70' 7" White Pine N60°W 48.33' 4" Maple N20°W 72.88' 7" Maple N85°W 15.50' 14" Pine Stump (R) South 11.61' 7" Wood Post North 1.0' Carbonite Witness Post	Placed 5" x 5" x 36" conc. monument using alignment of brushed line South of West edge of plantation North and the survey dimension to a swamp edge North, and is accepted as a careful and faithful reestablishment of the position of the original corner. N78°E 21.40' 15" Black Oak N75°W 33.83' 12" Sugar Maple S50°W 38.24' 10" Black Oak S20°W 14.69' 15" Sugar Maple

Signed *Norman C. Caldwell* Date 23 AUG. 1993  
13 JAN 1992

Surveyor's Michigan License No. 12018  
12018  
Corner E-9 E-10 ratified by the Manistee County Peer Group pursuant to P.A. 123 of 1915, as amended by P.A. 345 of 1990, as reviewed by Peer Review: MAY 3, 1993