

LAND CORNER RECORDATION CERTIFICATE
Filing Requirement of Act 74, Mich. P.A. 1970

For corners in

MANISTEE
 (County)

Located In:

Corner Code #

1. Public Land Survey	T	<u>21N</u>	R	<u>14W</u>	D-13	<u>E-11</u>
	T		R			
	T		R			
	T		R			
2. Property Controlling in Section	S		T	R		
	S		T	R		
3. Miscellaneous Property in Sec.	S		T	R		
	S		T	R		

REGISTER'S OFFICE
 MANISTEE COUNTY

#93-574 AT 4:35 p.m.

OCT 5 1993

Lenny A. Pipers
 REGISTER OF DEEDS

Register of Deeds Stamp & File Number

4. Lot No. _____, Recorded Plat _____
 5. Private Claims _____

I, Norman C. Caldwell, in a field survey on November, 1991, do hereby certify that under requirements of P.A. 74, Michigan P.A. of 1970, the corner points mentioned in lines 1 and 2 above were in conformance with regulations and rules therefore as required in the current manual of survey instructions of the United States Department of the Interior, Bureau of Land Management or by a decree of a Court of Law and/or that the corner points mentioned in lines 3, 4 and 5 above were in conformance with the rules of the Michigan Board of Land Surveyors or by a Decree of a Court of Law; established, re-established, monumented, re-monumented, recovered, found as expressed below:

NOTE: Not more than 4 corners, all in the same town and range, may be recorded on this certificate.

A	B	C	D	E	F	G	H	I	J	K	L	M
2	6	5	4	3	2	1						
3												
4	7	8	9	10	11	12						
5												
6	18	17	16	15	14	13						
7												
8	19	20	21	22	23	24						
9												
10	30	29	28	27	26	25						
11												
12	31	32	33	34	35	36						
13												

A. Description of original monument and accessories and/or subsequent restoration:


D-13 Standard 1/4 cor., Sec. 32, T21N-R14W E-11 Sec. cor., 28, 29, 32 & 33
 Post placed by John Brink in 1842 second correction line survey.
 N66°E 33 lks. (21.8') 8" Beech
 N60°W 17 lks. (11.2') 11" Hemlock

E-11 Sec. cor., 28, 29, 32 & 33
 Post placed by John Brink in 1842 subdivision survey.
 N82½°W 24 lks. (15.8') 10" Maple
 N60°E 7 lks. (4.6') 14" Hemlock

B. Description of corner evidence found and/or method applied in restoring or reestablishing corner:

D-13 Standard 1/4 cor., Sec. 32, T21N-R14W E-11 Sec. cor., 28, 29, 32 & 33
 No Subsequent Record

E-11 Sec. cor., 28, 29, 32 & 33
 Baird in 1908 placed a post and marked the following references.
 N78°W 7 lks. (4.62') Yellow Pine stump
 S54°30'E 22 lks. (14.5') 18" Yellow Pine stump
 N78°W (5.0') Yellow Pine stump (R)

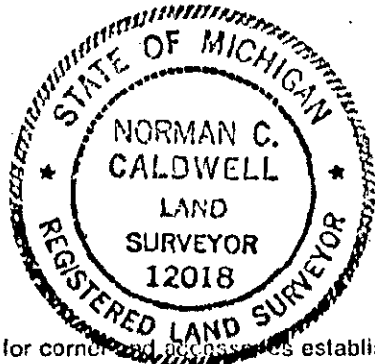

Corner E-11 ratified by the Manistee County Peer Group pursuant to P.A. 123 of 1915, as amended by P.A. 345 of 1990, as amended. Date of Peer Review: APRIL 5, 1993

C. Description of monument for corner and accessories established to perpetuate locating the position of the corner:

D-13 Standard 1/4 cor., Sec. 32, T21N-R14W E-11 Sec. cor., 28, 29, 32 & 33, T21N-R14W
 Placed 5" x 36" conc. monument w/brass cap #16923, on 2nd correction line, by single proportion method and validated by calls to original swamp edges and is accepted as a careful and faithful reestablishment of the position of the original corner.
 S16°W 19.58' 6" White Pine
 West 1.0' Carsonite Witness Post
 N04°E 16.84' 3" White Pine
 S77°E 50.73' 10" White Pine

E-11 Sec. cor., 28, 29, 32 & 33, T21N-R14W
 Placed 5" x 36" conc. monument w/brass cap #16923 from record pine stump and is accepted as a careful and faithful perpetuation of the position of the original corner.
 S84°W 24.56' 6" S. Maple
 S47°E 19.46' 5" S. Maple
 N53°E 39.45' 6" White Oak
 East 1.0' Carsonite Witness Post
 N08°W 45.62' 24" White Oak
 N78°W (5.0') Yellow Pine stump (R)

Signed by Norman C. Caldwell
Norman C. Caldwell
 Surveyor's Michigan License No. 12018

23 AUG 1993
10 JAN 1992