

LAND CORNER RECORDATION CERTIFICATE
Filing Requirement of Act 74, Mich. P.A. 1970

For corners in

MANISTEE

(County)

Located In:

Corner Code =#

- | | | | | | |
|-------------------------|---|------------|---|------------|-------------------|
| 1. Public Land Survey | T | <u>21N</u> | R | <u>14W</u> | <u>E-12, F-13</u> |
| | T | | R | | |
| | T | | R | | |
| | T | | R | | |
| 2. Property Controlling | S | | T | | |
| in Section | S | | T | | |
| 3. Miscellaneous | S | | T | | |
| Property in Sec. | S | | T | | |

REGISTER'S OFFICE
 MANISTEE COUNTY

93-571 AT 4:20 p.m.

OCT 5 1993

Penny A. Pappas
 REGISTER OF DEEDS

Register of Deeds Stamp & File Number

4. Lot No. _____, Recorded Plat _____
 5. Private Claims _____

Norman C. Caldwell in a field survey on November, 1991

do hereby certify that under requirements of P.A. 74, Michigan P.A. of 1970, the corner points mentioned in lines 1 and 2 above were in conformance with regulations and rules therefore as required in the current manual of survey instructions of the United States Department of the Interior, Bureau of Land Management or by a decree of a Court of Law and/or that the corner points mentioned in lines 3, 4 and 5 above were in conformance with the rules of the Michigan Board of Land Surveyors or by a Decree of a Court of Law; established, re-established, monumented, re-monumented, recovered, found as expressed below:

NOTE: Not more than 4 corners, all in the same town and range, may be recorded on this certificate.

| A | B | C | D | E | F | G | H | I | J | K | L | M |
|----|----|----|----|----|----|----|---|---|---|---|---|---|
| 2 | 6 | 5 | 4 | 3 | 2 | 1 | | | | | | |
| 3 | | | | | | | | | | | | |
| 4 | 7 | 8 | 9 | 10 | 11 | 12 | | | | | | |
| 5 | | | | | | | | | | | | |
| 6 | 18 | 17 | 16 | 15 | 14 | 13 | | | | | | |
| 7 | | | | | | | | | | | | |
| 8 | 19 | 20 | 21 | 22 | 23 | 24 | | | | | | |
| 9 | | | | | | | | | | | | |
| 10 | 30 | 29 | 28 | 27 | 26 | 25 | | | | | | |
| 11 | | | | | | | | | | | | |
| 12 | 31 | 32 | 33 | 34 | 35 | 36 | | | | | | |
| 13 | | | | | | | | | | | | |

A. Description of original monument and accessories and/or subsequent restoration:


- | | | | |
|------|---|------|--|
| E-12 | <u>1/4 cor., Sec. 32 & 33, T21N-R14W</u> | F-13 | <u>1/4 cor., Sec. 33, T21N-R14W</u> |
| | Post placed by John Brink in 1842 subdivision survey. N72°E 37 lks. (24.4') 18" Yellow Pine N85°W 49 lks. (32.3') 14" Yellow Pine | | Post placed by John Brink in 1842 subdivision survey. N44½°E 31 lks. (20.5') 11" Beech N52°W 55 lks. (36.3') 12" White Ash |

B. Description of corner evidence found and/or method applied in restoring or reestablishing corner:

- | | | | |
|------|---|------|---|
| E-12 | <u>1/4 cor., Sec. 32 & 33, T21N-R14W</u> | F-13 | <u>1/4 cor., Sec. 33, T21N-R14W</u> |
| | Baird in 1908 placed a post and marked the following references. S04°W 23 lks. (15.2') 18" Yellow Pine S20°E 6 lks. (3.96') 18" Yellow Pine | | Found 1" iron pipe placed by Robert Griffin in 1980 S02°W 45.98' 14" Twin Sugar Maple N24°E 27.97' 2" Ash |

C. Description of monument for corner and accessories established to perpetuate localizing the position of the corner:

- | | | | |
|------|---|------|---|
| E-12 | <u>1/4 cor., Sec. 32 & 33, T21N-R14W</u> | F-13 | <u>1/4 cor., Sec. 33, T21N-R14W</u> |
| | Placed 5" x 5" x 36" conc. monument w/brass tablet by single proportion method and is accepted as a careful and faithful reestablishment of the position of the original corner. S61°E 75.90' 8" Maple N85°E 57.31' 18" Black Oak N01°W 21.69' 6" Black Oak S05°W 24.87' 8" White Oak | | Fnd. 1" iron pipe placed by Robert Griffin in 1980 and replaced w/5" x 36" conc. monument w/brass tablet and is accepted as the best available evidence of the position of the original corner. S10°W 46.19' 12" Twin Maple S55°W 70.15' 12" Black Oak S05°E 99.81' 10" Maple S55°E 72.00' 15" Triple Maple |

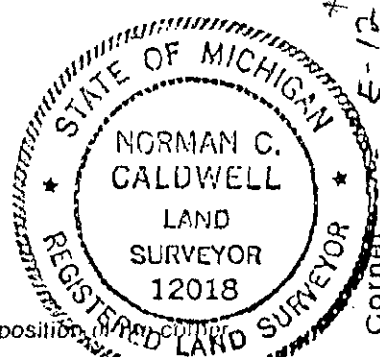

Corner E-12 ratified by the Manistee County Peer Group pursuant to P.A. 123 of 1915, as amended by P.A. 345 of 1990, as amended. Date of Peer Review: May 5, 1993

Signed by *Norman C. Caldwell* Date 23 AUG 1993
Norman C. Caldwell Date 10 JAN 1992

Surveyor's Michigan License No. 12018
 Corner E-13 ratified by the Manistee County Peer Group pursuant to P.A. 123 of 1915, as amended by P.A. 345 of 1990, as