

**LAND CORNER RECORDATION CERTIFICATE**  
**Filing Requirement of Act 74, Mich. P.A. 1970**

For corners in

MANISTEE  
 (County)

Located In:

Corner Code ##

1. Public Land Survey

T 21N R 14W  
 T \_\_\_\_\_ R \_\_\_\_\_  
 T \_\_\_\_\_ R \_\_\_\_\_  
 T \_\_\_\_\_ R \_\_\_\_\_

E-12 F-13  
 \_\_\_\_\_  
 \_\_\_\_\_  
 \_\_\_\_\_  
 \_\_\_\_\_

2. Property Controlling  
 in Section

S \_\_\_\_\_ T \_\_\_\_\_ R \_\_\_\_\_  
 S \_\_\_\_\_ T \_\_\_\_\_ R \_\_\_\_\_

3. Miscellaneous  
 Property in Sec.

S \_\_\_\_\_ T \_\_\_\_\_ R \_\_\_\_\_  
 S \_\_\_\_\_ T \_\_\_\_\_ R \_\_\_\_\_

4. Lot No. \_\_\_\_\_, Recorded Plat \_\_\_\_\_  
 5. Private Claims \_\_\_\_\_

REGISTER'S OFFICE  
 MANISTEE COUNTY  
 # 93-5711 AT 4:00 p.m.  
**OCT 5 1993**

*Penny A. Parn*  
 REGISTER OF DEEDS

Register of Deeds Stamp & File Number

I, Norman C. Caldwell, in a field survey on November, 1991

do hereby certify that under requirements of P.A. 74, Michigan P.A. of 1970, the corner points mentioned in lines 1 and 2 above were in conformance with regulations and rules therefore as required in the current manual of survey instructions of the United States Department of the Interior, Bureau of Land Management or by a decree of a Court of Law and/or that the corner points mentioned in lines 3, 4 and 5 above were in conformance with the rules of the Michigan Board of Land Surveyors or by a Decree of a Court of Law; established, re-established, monumented, re-monumented, recovered, found as expressed below:

**NOTE: Not more than 4 corners, all in the same town and range, may be recorded on this certificate.**

A	B	C	D	E	F	G	H	I	J	K	L	M
2	6	5	4	3	2	1						
3												
4	7	8	9	10	11	12						
5												
6	18	17	16	15	14	13						
7												
8	19	20	21	22	23	24						
9												
10	30	29	28	27	26	25						
11												
12	31	32	33	34	35	36						
13												

A. Description of original monument and accessories and/or subsequent restoration:

E-12 1/4 cor., Sec. 32 & 33, T21N-R14W

Post placed by John Brink in 1842 subdivision survey.  
 N72°E 37 lks. (24.4') 18" Yellow Pine  
 N85°W 49 lks. (32.3') 14" Yellow Pine

\* F-13 1/4 cor., Sec. 33, T21N-R14W

Post placed by John Brink in 1842 subdivision survey.  
 N44½°E 31 lks. (20.5') 11" Beech  
 N52°W 55 lks. (36.3') 12" White Ash

B. Description of corner evidence found and/or method applied in restoring or reestablishing corner:

E-12 1/4 cor., Sec. 32 & 33, T21N-R14W

Baird in 1908 placed a post and marked the following references.  
 S04°W 23 lks. (15.2') 18" Yellow Pine  
 S20°E 6 lks. (3.96') 18" Yellow Pine

\* F-13 1/4 cor., Sec. 33, T21N-R14W

Found 1" iron pipe placed by Robert Griffin in 1980  
 S02°W 45.98' 14" Twin Sugar Maple  
 N24°E 27.97' 2" Ash


C. Description of monument for corner and accessories established to perpetuate locating the position of the corner:

E-12 1/4 cor., Sec. 32 & 33, T21N-R14W

Placed 5" x 5" x 36" conc. monument w/brass tablet by single proportion method and is accepted as a careful and faithful reestablishment of the position of the original corner.  
 S61°E 75.90' 8" Maple  
 N85°E 57.31' 18" Black Oak  
 N01°W 21.69' 6" Black Oak  
 S05°W 24.87' 8" White Oak

\* F-13 1/4 cor., Sec. 33, T21N-R14W

Found 1" iron pipe placed by Robert Griffin in 1980 and replaced w/5" x 36" conc. monument w/brass tablet and is accepted as the best available evidence of the position of the original corner.  
 S10°W 46.19' 12" Twin Maple  
 S55°W 70.15' 12" Black Oak  
 S05°E 99.81' 10" Maple  
 S55°E 72.00' 15" Triple Maple

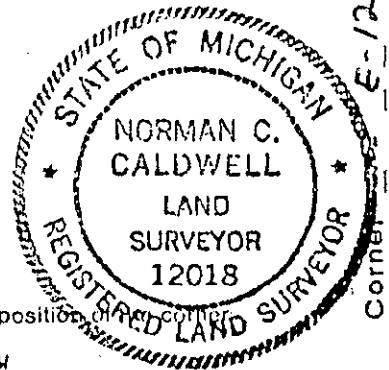

Corner E-12 ratified by the Manistee County Peer Group pursuant to P.A. 123 of 1915, as amended by P.A. 345 of 1990, as

Signed by *Norman C. Caldwell*  
*Norman C. Caldwell*

23 AUG 1993  
 10 JAN 1992

Surveyor's Michigan License No. 12018  
 \* Corner F-13 ratified by the Manistee County Peer Group pursuant to P.A. 123 of 1915, as amended by P.A. 345 of 1990, as  
 Date of Peer Review: APRIL 5, 1993