

JUL 2 8 1998

LAND CORNER RECORDATION CERTIFICATE

Filing Requirement of Act 74, Mich. P.A. 1970

SECTION

For corners in Manistee Located In: _____ Corner Code # _____
 (County)

1. Public Land Survey T 21N R 14W I-13
 T _____ R _____
 T _____ R _____
 T _____ R _____

2. Property Controlling in section S _____ T _____ R _____
 S _____ T _____ R _____

3. Miscellaneous Property in Sec. S _____ T _____ R _____
 S _____ T _____ R _____

REGISTER'S OFFICE
MANISTEE COUNTY

98-268 at 3:05 PM
JUL 07 1998

Deborah Dix
REGISTER OF DEEDS

Register of Deeds Stamp & File Number

4. Lot No. _____ Recorded Plat _____
 5. Private Claims _____

I, Kenneth L. Ross, in a field survey on June 3 19 98, do hereby certify that under requirements of P.A. 74, Michigan P.A. of 1970, the corner points mentioned in lines 1 and 2 above were in conformance with regulations and rules therefore as required in the current manual of survey instructions of the United States Department of the Interior, Bureau of Land Management or by a decree of a Court of Law and/or that the corner points mentioned in lines 3, 4 and 5 above were in conformance with the rules of the Michigan Board of Land Surveyors or by a Decree of a Court of Law, established, re-established, monumented, re-monumented, recovered, found as expressed below:

NOTE: Not more than 4 corners, all in the same town and range, may be recorded on this certificate.

A. Description of original monument and accessories and/or subsequent restoration:

I-13 Section Corner for Sections 34 & 35, on the township-line, T21N-R14W.

1838, John Brink, G.L.O. Boundary Survey
Set Wood Post

#1 Beech 8" N 57 1/2 E 32 lks. (21.12')
 #2 Beech 8" N 45 W 52 lks. (34.32')

1980, Robert A. Griffin, RLS #12018

Patric Leeson, surveyor trainee re-established the corner by proportional measurement and on a straight line between controlling corners. Set 5" sq. conc. monument, with 3 1/2" brass cap Fence corner running North & West North 25.7'

#3 White Oak 11" S 27 E 84.48'
 #4 White Pine 3" S 25 W 63.35
 #5 Pine Post 5" West 32.76
 #6 Red Maple 20" N 27 W 70.54'

B. Description of corner evidence found and/or method applied in restoring or reestablishing corner:

I-13 Section Corner for Sections 34 & 35, on the township-line, T21N-R14W.

On June 3, 1998, I found 5" square concrete monument with 3 1/2" brass cap, stamped to identify the corner. Monument sets 1.0 foot below road surface. I found no evidence to dispute this location for the corner.

Condition of record witnesses as follows are: #1 Gone #2 Gone #3 Found in good condition #4 Gone #5 Found to the North in good condition #6 Found in good condition

C. Description of monument for corner and accessories established to perpetuate locating the position of the corner:


I-13 Section Corner for Sections 34 & 35, on the township-line, T21N-R14W.

I accepted 5" square x 36" concrete monument with brass cap as a substantial marker for the corner, and is accepted as a careful and faithful re-establishment of the position of the original corner.

Ext. "BT" #3 White Oak 18" S 27 E 84.48' (10" dock spike in NE side of tree)
 Ext. "BT" #6 Red Maple 24" N 27 W 70.48' (10" dock spike in NE side of tree)
 New "BT" #7 Red Oak 32" N 55 E 49.02' (60d spike in SE side of tree)
 New "BT" #8 White Pine 6" S 40 W 54.84' (60d spike in SE side of tree)

Signed by *Kenneth L. Ross* Date July 2, 1998

Surveyor's Michigan License No. 17634

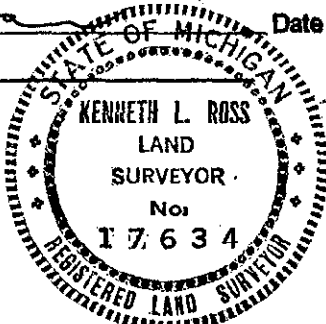

	A	B	C	D	E	F	G	H	I	J	K	L	M
1													
2	6	5	4	3	2	1							
3													
4	7	8	9	10	11	12							
5													
6	18	17	16	15	14	13							
7													
8	19	20	21	22	23	24							
9													
10	30	29	28	27	26	25							
11													
12	31	32	33	34	35	36							
13													

ratified by the Manistee County Peer Group according to the county plan adopted pursuant to P.A. 345 of 1990, as amended, (being the State Survey and Remonument Act, MCL 54.261 et. seq.) Date of Peer Review: July 7, 1998

Anthony M. Stawicki