

Same as L-1 ✓
T21N, R14W

LAND CORNER RECORDATION CERTIFICATE
Filing Requirement of Act 74, Mich. P.A. 1970

SECTION

For corners in
MANISTEE
(County)

Located In: _____ Corner Code # _____

1. Public Land Survey T 22N R 14W L-13
T _____ R _____
T _____ R _____
T _____ R _____

2. Property Controlling in Section S _____ T _____ R _____
S _____ T _____ R _____

3. Miscellaneous Property in Sec. S _____ T _____ R _____
S _____ T _____ R _____

4. Lot No. _____ Recorded Plat _____

5. Private Claims _____

REGISTER'S OFFICE
MANISTEE COUNTY
99-173 at 4:10 pm
MAY 20 1999
Deborah Dix
REGISTER OF DEEDS

Register of Deeds Stamp & File Number

	A	B	C	D	E	F	G	H	I	J	K	L	M
1													
2	6	5	4	3	2	1							
3													
4	7	8	9	10	11	12							
5													
6	18	17	16	15	14	13							
7													
8	19	20	21	22	23	24							
9													
10	30	29	28	27	26	25							
11													
12	31	32	33	34	35	36							
13													

I, Richard L. Hays, in a field survey on April 29 19 99, do hereby certify that under requirements of P.A. 74, Michigan P.A. of 1970, the corner points mentioned in lines 1 and 2 above were in conformance with regulations and rules therefore as required in the current manual of survey instructions of the United States Department of the Interior, Bureau of Land Management or by a decree of a Court of Law and/or that the corner points mentioned in lines 3, 4 and 5 above were in conformance with the rules of the Michigan Board of Land Surveyors or by a Decree of a Court of Law; established, re-established, monumented, re-monumented, recovered, found as expressed below:

NOTE: Not more than 4 corners, all in the same town and range, may be recorded on this certificate.

A. Description of original monument and accessories and/or subsequent restoration:

L-13 South 1/4 corner for Section 36, T22N-R14W and North 1/4 for Section 1, T21N-R14W, on the Township line.

1837, John Brink, G.L.O., Boundary survey
Set Wood Post

- #1 P. Pine 9" N 59 E 36 lks. (23.76')
- #2 P. Pine 11" N 76 W 28 lks. (18.48')

1909, EWM, Manistee county surveyor
Found Gas Pipe

- #3 Black Oak 10" N 34 E 100 lks. (66.00')
- #4 Black Oak 10" N 22 W 127 lks. (83.82')

1939, A. P. Yale

- Found 3/4" Iron Pipe
- #5 cedar Post S 02 E 37 lks. (24.42')

1971, Kerte's

- Found Gas Pipe
- #6 Guy wire Pole 7' S 36 W 42.00'

- #7 White Oak 7" N 48 E 58.03'
- #8 White Oak 8" S 40 E 80.15'

1978, Found 3/4" gas Pipe, replaced with a 5"sq. x 36" concrete monument with Brass cap.

- #9 White Oak 6" N 48 E 57.3'
- #10 White Oak 8" S 46 E 79.81' (same as #7)
- #11 Guy wire Pole S 38 W 42.66' (same as #6)
- #12 Pine Post Post 3" North 33.15'

B. Description of corner evidence found and/or method applied in restoring or reestablishing corner:

L-13 South 1/4 corner for Section 36, T22N-R14W and North 1/4 Corner for Section 1, T21N-R14W.

On April 29, 1999, Kevin Pritchard (survey tech.) and I found a 5" sq. concrete monument, stamped to identify the corner, at the intersection of Old House Road and Baker Roads, one foot below road surface. I found no evidence to disputed this location for the corner.

CONDITION OF RECORD WITNESSES ARE AS FOLLOWS: #1 Gone #2 Gone #3 Gone #4 Gone #5 Gone

#6 Found in good condition #7 Gone #8 Found in good condition #9 Same as #7

#10 Found in good condition #11 Same as #6 #12 Found in good condition


C. Description of monument for corner and accessories established to perpetuate locating the position of the corner.

L-13 South 1/4 corner for Section 36, T22N-R14W and North 1/4 Corner for Section 1, T21N-R14W.

I accepted the 5" sq by 36" concrete monument with brass cap, stamped to identify the corner as a substantial marker for the corner and is accepted as a careful and faithful re-establishment for the position of the original corner.

- ext. BT #6 Guy wire pole S 38 W 42.80' (set P.K. nail in SE side of pole)
- ext. BT #8 White Oak 12" S 46 E 86.02' (set 60d spike SW side of tree)
- New BT Power Pole N 62 E 40.12' (Found 30d spike in SE side of pole)
- New BT Black Oak S 84 W 65.70' (set 60d spike in South side of tree)

Signed by Richard Hays
Surveyor's Michigan License No. 25847

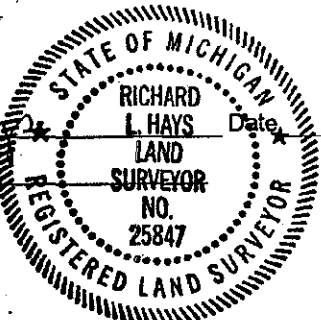

Date 5/19/99

ratified by the Manistee County Peer Group
 according to the county plan adopted pursuant to P.A. 345 of 1990,
 as amended, (being the State Survey and Remonument Act, MCL 54.261
 et seq.) - Date of Peer Review: 5-13-99

MAY 19 1999