

LAND CORNER RECORDATION CERTIFICATE
Filing Requirement of Act 74, Mich. P.A. 1970

For corners in
Manistee
 (County)

Located In:

Corner Code ##

1. Public Land Survey

T 21N R 13W
 T _____ R _____
 T _____ R _____
 T _____ R _____

A-6 = M-6 T21N R14W

2. Property Controlling
 in Section

S 18 T 21N R 13W
 S _____ T _____ R _____

18-15

3. Miscellaneous
 Property in Sec.

S _____ T _____ R _____
 S _____ T _____ R _____

Register of Deeds Stamp & File Number

#93-327

4. Lot No. _____, Recorded Plat _____

5. Private Claims _____

I, Norman C. Caldwell, in a field survey on September, 19 92

do hereby certify that under requirements of P.A. 74, Michigan P.A. of 1970, the corner points mentioned in lines 1 and 2 above were in conformance with regulations and rules therefore as required in the current manual of survey instructions of the United States Department of the Interior, Bureau of Land Management or by a decree of a Court of Law and/or that the corner points mentioned in lines 3, 4 and 5 above were in conformance with the rules of the Michigan Board of Land Surveyors or by a Decree of a Court of Law; established, re-established, monumented, re-monumented, recovered, found as expressed below:

NOTE: Not more than 4 corners, all in the same town and range, may be recorded on this certificate.


	A	B	C	D	E	F	G	H	I	J	K	L	M
2	6		5		4		3		2		1		
3													
4	7		8		9		10		11		12		
5													
6	16		17		16		15		14		13		
7													
8	19		20		21		22		23		24		
9													
10	30		29		28		27		26		25		
11													
12	31		32		33		34		35		36		
13													

A. Description of original monument and accessories and/or subsequent restoration:

A-6 Post placed by John Brink, Sept. 1837
 N61°W 35 lks. (23.10') 11" Birch
 S37°W 45 lks. (29.70') 10" Birch

18-15

This position not established by original government survey

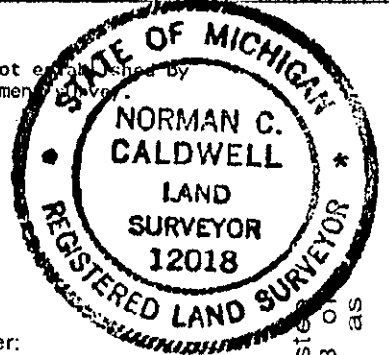

B. Description of corner evidence found and/or method applied in restoring or reestablishing corner:

A-6 1/4 common to Sec. 18, T21N-R13W & Sec. 13, T21N-R14W
 County Surveyors record S. H. Baker - date unknown
 No Monument Given
 N37 1/4°E 78.7' 8" Water Elm
 S58°W 46 1/4' 14" Hemlock Stump

18-15

W 1/16' cor., Sec. 18 & 19, T21N-R13W
 County Surveyors Record Fargo Eng. Co. December 1918
 Monument - Gas Pipe
 S29 1/4°W 26.00' 10" Tamarak
 S78°E 28.00' 8" Tamarak

County Surveyors copy of minutes of Survey Theodore Norlin in June 1922
 Fnd. old stake
 S14°W 55.3' 18" B. Oak
 S68°E 46.0' 15" Maple

County Surveyors copy of minutes of Survey Theodore Norlin in June 1922
 Monument - stake
 S29°W 26.00' 10" Tamarak
 S78°E 28.00' 8" Tamarak

Unrecorded survey by K. Ross in 1973
 Monument - 1" Pipe
 East 25.76' 12" W. Pine
 SW 14.20' 10" W. Pine
 NW 29.78' 12" W. Pine
 (Fnd. in U.S.F.S. Land Corner Record)

C. Description of monument for corner and accessories established to perpetuate locating the position of the corner:

A-6 1/4 common to Sec. 18, T21N-R13W & Sec. 13, T21N-R14W
 At proportion dist. found
 No evidence of record monument, placed 2" iron pipe with brass cap and is accepted as a careful and faithful reestablishment of the position of the original corner.
 S42°W 52.33' 15" W. Pine
 N55°W 25.57' 18" W. Pine
 S52°E 46.28' 18" W. Pine
 N38°E 74.85' 20" W. Pine
 N07°E 230.82' 5 1/4" Pipe #12018
 North 1.0' Carsonite Witness Post

18-15

W 1/16' cor., Sec. 18 & 19, T21N-R13W
 Fnd. 1 1/2" diam. iron pipe, placed 5/8" x 1/2" reord w/alum. cap inside existing iron pipe is 1.2" above conc. block. This position is established by original government survey, monument is accepted as a careful and faithful determination of the position of the corner.
 S10°E 33.15' 8" W. Pine
 S00°W 53.93' 9" W. Pine
 N30°W 29.53' 5" W. Pine
 N81°E 22.01' 7" W. Pine
 West 1.0' Carsonite Witness Post

Signed by Norman C. Caldwell

Date

Surveyor's Michigan License No. 12018

ratified by the Manistee County Peer Group pursuant to P.A. 123 of 1918, as amended by P.A. 345 of 1990, as amended. Date of Peer Review: April 8, 1993.