

**LAND CORNER RECORDATION CERTIFICATE**

**Filing Requirement of Act 74, Mich. P.A. 1970**

For corners in MANISTEE Located In: \_\_\_\_\_ Corner Code # \_\_\_\_\_  
 (County)

1. Public Land Survey T 21N R 17W F-13  
 T \_\_\_\_\_ R \_\_\_\_\_  
 T \_\_\_\_\_ R \_\_\_\_\_  
 T \_\_\_\_\_ R \_\_\_\_\_

2. Property Controlling S T R \_\_\_\_\_  
 in Section S T R \_\_\_\_\_  
 3. Miscellaneous S T R \_\_\_\_\_  
 Property in Sec. S T R \_\_\_\_\_

4. Lot No. \_\_\_\_\_ Recorded Plat \_\_\_\_\_

5. Private Claims \_\_\_\_\_

**REGISTER'S OFFICE  
 MANISTEE COUNTY**  
 98-261 at 4:10pm  
**JUL 01 1998**  
*Elizabeth Six*  
**REGISTER OF DEEDS**

Register of Deeds Stamp & File Number

I, Richard L. Hays, in a field survey on April 1998, do hereby certify that under requirements of P.A. 74, Michigan P.A. of 1970, the corner points mentioned in lines 1 and 2 above were in conformance with regulations and rules therefore as required in the current manual of survey instructions of the United States Department of the Interior, Bureau of Land Management or by a decree of a Court of Law and/or that the corner points mentioned in lines 3, 4 and 5 above were in conformance with the rules of the Michigan Board of Land Surveyors or by a Decree of a Court of Law; established, re-established, monumented, re-monumented, recovered, found as expressed below:

**NOTE: Not more than 4 corners, all in the same town and range, may be recorded on this certificate.**

A. Description of original monument and accessories and/or subsequent restoration:  
 SOUTH QUARTER CORNER OF SECTION 33, T21N-R17W  
 1838: G.L.O. Survey by John Brink Set Post  
 10" Beech N-20°-E 16 Lks(1)  
 10" Beech S-50°-W 30 Lks(2)  
 1979: Nordlund & Dunlap Survey  
 Found Pipe  
 Fence Post S-78°-E 78.69' (3)  
 Trip Pine S-05°-W 32.50' (4)  
 12" Cedar N-60°-W 59.00' (5)


B. Description of corner evidence found and/or method applied in restoring or reestablishing corner:  
 SOUTH QUARTER CORNER OF SECTION 33, T21N-R17W  
 APRIL 1998: Found 1/2" Iron Pin 3.00' North of Centerline of Road. Condition of the witnesses are as follows:  
 10" Beech N-20°-E 16 Lks(1) GONE  
 10" Beech S-50°-W 30 Lks(2) GONE  
 Fence Post S-78°-E 78.69' (3) FOUND  
 Trip Pine S-05°-W 32.50' (4) GONE  
 12" Cedar N-60°-W 59.00' (5) FOUND

C. Description of monument for corner and accessories established to perpetuate locating the position of the corner:  
 SOUTH QUARTER CORNER OF SECTION 33, T21N-R17W  
 APRIL 1998: Accepted 1/2" Iron Pin and replaced with a MANISTEE COUNTY MONUMENT as the best available evidence of the position of the Corner.  
 14" Cedar Clump N-60°-W 59.00' (5) 60 Penny Spike  
 10" Fence Post with MDOT Tag S-67°-E 78.89' (3) 60 Penny Spike  
 12" Red Pine S-05°-E 33.51' 60 Penny Spike  
 12" Red Pine S-45°-W 51.30' 60 Penny Spike  
 1" Iron Pipe North 33.08'

|    | A  | B  | C  | D  | E  | F  | G | H | I | J | K | L | M |
|----|----|----|----|----|----|----|---|---|---|---|---|---|---|
| 1  |    |    |    |    |    |    |   |   |   |   |   |   |   |
| 2  | 6  | 5  | 4  | 3  | 2  | 1  |   |   |   |   |   |   |   |
| 3  |    |    |    |    |    |    |   |   |   |   |   |   |   |
| 4  | 7  | 8  | 9  | 10 | 11 | 12 |   |   |   |   |   |   |   |
| 5  |    |    |    |    |    |    |   |   |   |   |   |   |   |
| 6  | 18 | 17 | 16 | 15 | 14 | 13 |   |   |   |   |   |   |   |
| 7  |    |    |    |    |    |    |   |   |   |   |   |   |   |
| 8  | 19 | 20 | 21 | 22 | 23 | 24 |   |   |   |   |   |   |   |
| 9  |    |    |    |    |    |    |   |   |   |   |   |   |   |
| 10 | 30 | 29 | 28 | 27 | 26 | 25 |   |   |   |   |   |   |   |
| 11 |    |    |    |    |    |    |   |   |   |   |   |   |   |
| 12 | 31 | 32 | 33 | 34 | 35 | 36 |   |   |   |   |   |   |   |
| 13 |    |    |    |    |    |    |   |   |   |   |   |   |   |

Corner \_\_\_\_\_ ratified by the Manistee County Peer Group according to the county plan adopted pursuant to P.A. 345 of 1970 amended, (being the State Survey and Remonument Act, MCL 54.2 et seq.). Date of Peer Review: MAY 5 1998

Signed by Richard Hays  
 Surveyor's Michigan License No. 25847

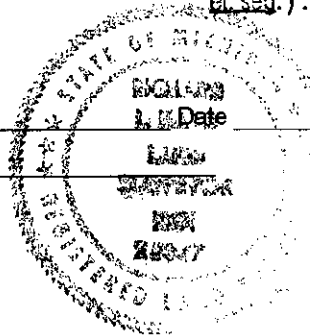

May 1, 1998