

LAND CORNER RECORDATION CERTIFICATE

Filing Requirement of Act 74, Mich. P.A. 1970

For corners in SECTION
MANISTEE
(County)

Located In: _____ Corner Code # _____

1. Public Land Survey T 21N R 17W H-13
T _____ R _____
T _____ R _____
T _____ R _____
2. Property Controlling in Section S _____ T _____ R _____
S _____ T _____ R _____
3. Miscellaneous S _____ T _____ R _____
Property in Sec. S _____ T _____ R _____
4. Lot No. _____, Recorded Plat _____
5. Private Claims _____

**REGISTER'S OFFICE
MANISTEE COUNTY**

98-364 at 4:15 pm
JUL 01 1998

Rebecca Six
REGISTER OF DEEDS

Register of Deeds Stamp & File Number

I, Richard L. Hays, in a field survey on April 1998, do hereby certify that under requirements of P.A. 74, Michigan P.A. of 1970, the corner points mentioned in lines 1 and 2 above were in conformance with regulations and rules therefore as required in the current manual of survey instructions of the United States Department of the Interior, Bureau of Land Management or by a decree of a Court of Law and/or that the corner points mentioned in lines 3, 4 and 5 above were in conformance with the rules of the Michigan Board of Land Surveyors or by a Decree of a Court of Law; established, re-established, monumented, re-monumented, recovered, found as expressed below:

NOTE: Not more than 4 corners, all in the same town and range, may be recorded on this certificate.

A. Description of original monument and accessories and/or subsequent restoration:

SOUTH QUARTER CORNER OF SECTION 34, T21N-R17W
1838: G.L.O. Survey by John Brink Set post.
10" Beech N-64 1/2°-E 46 Lks (1)
12" Beech N-09°-W 30 Lks (2)

1993: Anthony Slawinski Survey:
Found 1" Pipe in Monument Box
NO WITNESSES

B. Description of corner evidence found and/or method applied in restoring or reestablishing corner:

SOUTH QUARTER CORNER OF SECTION 34, T21N-R17W
APRIL 1998: Found 1-1/4" Pipe in Monument Box in the Centerline of East-West Road with Fence line to the North
Condition of the witnesses are as follows:
10" Beech N-64 1/2°-E 46 Lks (1) GONE
12" Beech N-09°-W 30 Lks (2) GONE

C. Description of monument for corner and accessories established to perpetuate locating the position of the corner:


SOUTHEAST QUARTER CORNER OF SECTION 34, T21N-R17W
APRIL 1998: Accepted 1-1/4" Pipe in Monument Box and replaced with a MANISTEE COUNTY MONUMENT as the best available evidence of the position of the Corner.
1" Iron Pipe Capped with AMS N-06°-E 33.00'
Power Pole N-02°-E 28.92' 60 Penny Nail
Set 1/2" Re-Rod N-46°-E 30.50'
Set 1/2" Re-Rod S-30°-E 32.47'
Set 1/2" Re-Rod S-34°-W 29.71'

	A	B	C	D	E	F	G	H	I	J	K	L	M
1													
2	6	5	4	3	2	1							
3													
4	7	8	9	10	11	12							
5													
6	18	17	16	15	14	13							
7													
8	19	20	21	22	23	24							
9													
10	30	29	28	27	26	25							
11													
12	31	32	33	34	35	36							
13													

Corner H-13 ratified by the Manistee County Peer Group according to the county plan adopted pursuant to P.A. 345 of 1990, as amended, (being the State Survey and Remonument Act, MCL 54.261 (R.S.)) Date of Peer Review: MAY 5 1998

Signed by Richard Hays
Surveyor's Michigan License No. 25847

Anthony M. Slawinski
Date May 1, 1998

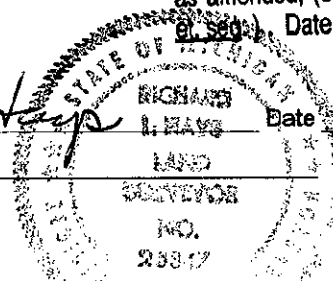

FORM APPROVED BY MICHIGAN STATE BOARD OF LAND SURVEYORS.