

SURVEY & REMONUMENTATION

JUL 14 1994

COMMISSION

LAND CORNER RECORDATION CERTIFICATE
Filing Requirement of Act 74, Mich. P.A. 1970

For corners in

MANISTEE (County)	Located In:	Corner Code #
1. Public Land Survey	T <u>21N</u> R <u>17W</u>	<u>1-5</u>
	T _____ R _____	_____
	T _____ R _____	_____
	T _____ R _____	_____
2. Property Controlling in Section	S _____ T _____ R _____	_____
	S _____ T _____ R _____	_____
3. Miscellaneous Property in Sec.	S _____ T _____ R _____	_____
	S _____ T _____ R _____	_____

REGISTER'S OFFICE
 MANISTEE COUNTY
 #94-268 AT 11:00 A.M.

JUN 15 1994

Perry A. Peares
 REGISTER OF DEEDS

Register of Deeds Stamp & File Number

4. Lot No. _____, Recorded Plat _____
 5. Private Claims _____

I, Sammy S. Barnett, in a field survey on APRIL, 19 94, do hereby certify that under requirements of P.A. 74, Michigan P.A. of 1970, the corner points mentioned in lines 1 and 2 above were in conformance with regulations and rules therefore as required in the current manual of survey instructions of the United States Department of the Interior, Bureau of Land Management or by a decree of a Court of Law and/or that the corner points mentioned in lines 3, 4 and 5 above were in conformance with the rules of the Michigan Board of Land Surveyors or by a Decree of a Court of Law; established, re-established, monumented, re-monumented, recovered, found as expressed below:

	A	B	C	D	E	F	G	H	I	J	K	L	M
2	6		5		4		3		2		1		
3													
4	7		8		9		10		11		12		
5									●				
6	13		17		16		15		14		13		
7													
8	19		20		21		22		23		24		
9													
10	30		29		28		27		26		25		
11													
12	31		32		33		34		35		36		
13													

NOTE: Not more than 4 corners, all in the same town and range, may be recorded on this certificate.

A. Description of original monument and accessories and/or subsequent restoration:

I-5 Section corner, Sec's, 10,11,14 & 15, T21N,R17W.

John Brink, D.S. G.L.O. Page 431

- #1 Hemlock 18" S 68° E 51ks. (3.30')
- #2 Hemlock 9" N 68° W 291ks.(19.14')

1935 State Hwy. Dept.

- Boat Spike Book A Pg. 78
- #3 Stake N 49° W 55.4'
- #4 Stake S 49° E 47.3'
- #5 Stake N 49° E 51.8'
- #6 Stake S 49° W 46.3'

B. Description of corner evidence found and/or method applied in restoring or reestablishing corner:

I-5 Section corner, Sec's., 10,11,14 & 15, T21N,R17W.

On March 31, 1994, found a 1½" Iron Pipe flush with road surface and at the center-line of Road. Also found Concrete plat monument 33 feet South of corner. Also found under 1½" x 24" Iron Pipe, found an old small Wood Stake. Condition of record witnesses are; #1 Gone #2 Gone #3 Gone #4 Gone #5 Gone #6 Gone

C. Description of monument for corner and accessories established to perpetuate locating the position of the corner:


I-5 Section corner, Sec's., 10,11,14 & 15, T21N,R17N.

Replaced 1½" Iron Pipe with a Manistee County monument (2½" x 30" steel pipe with a brass cap), placed in a monument box, and is accepted as a careful and faithful reestablishment of the position of the original corner.

- Red Pipe 2" N 42° W 77.98' (Note; pipe is on NE side of 26" S. Maplc)
- NW corner of brick house S 10° E 82.95'
- NE corner of brick house S 58° W 138.97'
- Set R.L.S. cap Re-Rod for witness N 47° E 49.90' (Note re-rod under fence line)

Signed by Sammy S. Barnett
 Surveyor's Michigan License No. 16923

Date 6/3/94

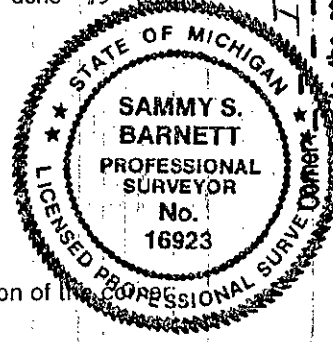

ratified by the Manistee County Peer Group according to the county plan adopted pursuant to P.A. 345 of 1990 as amended, (being the State Survey and Remonument Act MCL 54.26 et seq.) . Date of Peer Review: 6/16/94