

**SURVEY & REMONUMENTATION**

JUL 14 1994

COMMISSION

**LAND CORNER RECORDATION CERTIFICATE**  
Filing Requirement of Act 74, Mich. P.A. 1970

For corners in

<u>MANISTEE</u> <small>(County)</small>	Located In:	Corner Code --#
1. Public Land Survey	T <u>21N</u> R <u>17W</u>	<u>I-7</u>
	T _____ R _____	_____
	T _____ R _____	_____
	T _____ R _____	_____
2. Property Controlling in Section	S _____ T _____ R _____	_____
	S _____ T _____ R _____	_____
3. Miscellaneous Property in Sec.	S _____ T _____ R _____	_____
	S _____ T _____ R _____	_____

REGISTER'S OFFICE  
MANISTEE COUNTY

#94-259 AT 10:55 A.M.

JUN 15 1994

*Penney A. Rare*  
REGISTER OF DEEDS

Register of Deeds Stamp & File Number

4. Lot No. \_\_\_\_\_, Recorded Plat \_\_\_\_\_  
5. Private Claims \_\_\_\_\_

	A	B	C	D	E	F	G	H	I	J	K	L	M
2	6	5	4	3	2	1							
3													
4	7	8	9	10	11	12							
5													
6	18	17	16	15	14	13							
7													
8	19	20	21	22	23	24							
9													
10	30	29	28	27	26	25							
11													
12	31	32	33	34	35	36							
13													

I, Sammy S. Barnett, in a field survey on April, 1994, do hereby certify that under requirements of P.A. 74, Michigan P.A. of 1970, the corner points mentioned in lines 1 and 2 above were in conformance with regulations and rules therefore as required in the current manual of survey instructions of the United States Department of the Interior, Bureau of Land Management or by a decree of a Court of Law and/or that the corner points mentioned in lines 3, 4 and 5 above were in conformance with the rules of the Michigan Board of Land Surveyors or by a Decree of a Court of Law; established, re-established, monumented, re-monumented, recovered, found as expressed below:

**NOTE: Not more than 4 corners, all in the same town and range, may be recorded on this certificate.**

**A. Description of original monument and accessories and/or subsequent restoration:**

I-7 Section corner, Sec's., 14,15,22 & 23, T21N,R17W.

1839, John Brink D.S., G.L.O. Page 422

Set Wood Post

#1 Birch 11" S 67° E 431k. (28.38')

#2 Birch 10" S 42° W 391k. (25.74')

July 7, 1909, E. W. Muenscher Book A P78

Gas Pipe Set

#3 Pine Stump N 12½° E 461k. (30.36')

May 20, 1972, Tony Slawinski Act 74 L72 P6

Iron Rod

#4 Maple 4" S 45° E 57.86'

#5 Fence corner post S 45° W 46.18'

April 10, 1994, Bruce Jenema Act 74 L91 P326

Found 1" Iron Pipe

(OVER)

**B. Description of corner evidence found and/or method applied in restoring or reestablishing corner:**

I-7 Section corner, Sec's., 14,15,22 & 23, T21N,R17W.

On March 31, 1994, found 3/4" iron Rod flush with road surface and at the intersection of Red Apple Road and Wildwood Road.

Condition of record witnesses are; #1 Gone #2 Gone #3 Gone #4

#5 Gone #6 Found in good cond. #7 Found in good cond. #8 Found in good cond.

#9 Found in good cond.

NOTE: Found old 1" x 24" Gas Pipe under 3/4" iron pipe.

**C. Description of monument for corner and accessories established to perpetuate locating the position of the corner:**

I-7 Section corner, Sec's., 14,15,22 & 23, T21N,R17W.

Replaced 3/4" Iron Rod with a Manistee County monument ( 2½" x 30" steel pipe with a brass cap), placed in a monument box, and is accepted as a careful and faithful reestablishment of the position of the original corner.


(OBT) Power Pole S 44° E 43.94'

(OBT) Power Pole S 17° E 125.40'

(OBT) Red Pine 6" S 38° W 51.10'

Red Pine 7" N 47° W 91.14'

Corner I-7 ratified by the Manistee County Peer Group according to the county plan adopted pursuant to P.A. 345 of 1990, as amended, (being the State Survey and Remonument Act, MCL 54.261 et seq.). Date of Peer Review: 6/3/94

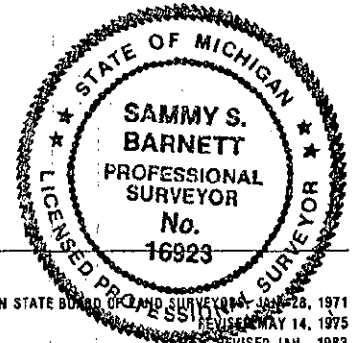

Signed by Sammy S. Barnett  
Surveyor's Michigan License No. 16923

Date 6/3/94

April 10, 1991, Bruce Jenema

Found 1" Iron Pipe

#6 Concrete Plat monument 33' North  
#7 Power Pole S 50° E 44.10'  
#8 MBT Riser S 50° W 45.30'  
#9 MBT Riser N 65° W 38.85'