

SURVEY & REMONUMENTATION

JUL 14 1994

COMMISSION

REGISTER'S OFFICE
MANISTEE COUNTY

#94-258 AT 10:50 A.M.

JUN 15 1994

Sammy S. Barnett
REGISTER OF DEEDS

Register of Deeds Stamp & File Number

LAND CORNER RECORDATION CERTIFICATE
Filing Requirement of Act 74, Mich. P.A. 1970

For corners in

MANISTEE
(County)

Located In:

Corner Code #

1. Public Land Survey

T 21N R 17W

I-8

T _____ R _____

T _____ R _____

T _____ R _____

2. Property Controlling in Section

S _____ T _____ R _____

S _____ T _____ R _____

3. Miscellaneous Property in Sec.

S _____ T _____ R _____

S _____ T _____ R _____

4. Lot No. _____, Recorded Plat _____

5. Private Claims _____

I, Sammy S. Barnett, in a field survey on April, 19 94, do hereby certify that under requirements of P.A. 74, Michigan P.A. of 1970, the corner points mentioned in lines 1 and 2 above were in conformance with regulations and rules therefore as required in the current manual of survey instructions of the United States Department of the Interior, Bureau of Land Management or by a decree of a Court of Law and/or that the corner points mentioned in lines 3, 4 and 5 above were in conformance with the rules of the Michigan Board of Land Surveyors or by a Decree of a Court of Law; established, re-established, monumented, re-monumented, recovered, found as expressed below:

NOTE: Not more than 4 corners, all in the same town and range, may be recorded on this certificate.

	A	B	C	D	E	F	G	H	I	J	K	L	M
2	6	5	4	3	2	1							
3													
4	7	8	9	10	11	12							
5													
6	18	17	16	15	14	13							
7													
8	19	20	21	22	23	24							
9													
10	30	29	28	27	26	25							
11													
12	31	32	33	34	35	36							
13													

A. Description of original monument and accessories and/or subsequent restoration:

I-8 1/4 corner, Sec's., 22 & 23, T21N,R17W.

1839, John Brink D. S., G.L.O. Page 422
Set Wood Post

#1 Y. Pine 14" N 43° E 281k. (18.48')
#2 Aspen 8" N 62° W 231k. (15.18')

July 7, 1909, E. W. Muenscher Book A P 78

Set 1/4 post by single proportional measurement
Set gas pipe
#3 W. Oak 5" West 11 1/2 k. (7.59')
#4 Oak 8" N 15 1/2° E 22 1/2 k. (14.85')
#5 Oak 6" S 68° W 631k. (41.58')

B. Description of corner evidence found and/or method applied in restoring or reestablishing corner:

I-8 1/4 corner, Sec's., 22 & 23, T21NR17W.

On March 31, 1994, found a 3/4" Iron Rod .2' below road surface, also found 1" Iron Pipe 32.89' East of corner.

Condition of record witnesses are; #1 Gone #2 Gone #3 Gone #4 Gone #5 Gone

C. Description of monument for corner and accessories established to perpetuate locating the position of the corner:


I-8 1/4 corner, Sec's., 22 & 23, T21N,R17W.

Replaced 3/4" Iron Rod with a Manistee County monument (2 1/2" x 30" steel pipe with a brass cap), placed in a monument box, and is accepted as a careful and faithful reestablishment of the position of the original corner.

B1. Oak 10" S 74° W 57.11'
B1. Oak 12" N 64° W 46.16'
R. Oak 12" N 83° E 49.74'
B1. Oak 10" S 57° E 55.70'

ratified by the Manistee County Peer Group according to the county plan adopted pursuant to P.A. 345 of 1990, as amended, (being the State Survey and Remonument Act NCL 54.261 et. seq.). Date of Peer Review: 6/16/94

Corner I-8

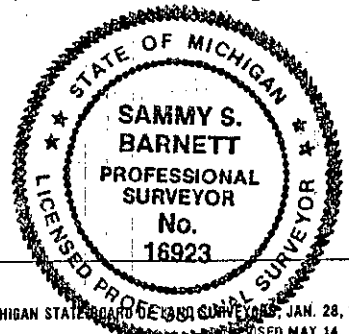

Signed by Sammy S. Barnett
Surveyor's Michigan License No. 16923

Date 6/3/94