

SECTION

LAND CORNER RECORDATION CERTIFICATE


Filing Requirement of Act 74, Mich. P.A. 1970

For corners in

<u>Manistee</u> (County)	Located In:	Corner Code #
1. Public Land Survey	T <u>21N</u> R <u>17W</u>	<u>J-05</u>
	T _____ R _____	<u>South 1/4 Cor.</u>
	T _____ R _____	<u>Sec. 11</u>
	T _____ R _____	_____
2. Property Controlling in Section	S _____ T _____ R _____	_____
	S _____ T _____ R _____	_____
3. Miscellaneous Property in Sec.	S _____ T _____ R _____	_____
	S _____ T _____ R _____	_____
4. Lot No. _____, Recorded Plat _____		
5. Private Claims _____		

REGISTER'S OFFICE  
**MANISTEE COUNTY**  
 98-241 at 9:10AM  
**JUN 29 1998**  
*Deborah Six*  
 REGISTER OF DEEDS  
 Register of Deeds Stamp & File Number

I, Anthony M. Slawinski, in a field survey on May 21, 19 98 do hereby state that under requirements of P.A. 74, Michigan P.A. of 1970, the corner points mentioned in lines 1 and 2 above were in conformance with regulations and rules therefore as required in the current manual of survey instructions of the United States Department of the Interior, Bureau of Land Management or by a decree of a Court of Law and /or that the corner points mentioned in lines 3, 4 and 5 above were in conformance with the rules of the Michigan Board of Land Surveyors or by a Decree of a Court of Law; established, re-established, monumented, recovered, found as expressed below:

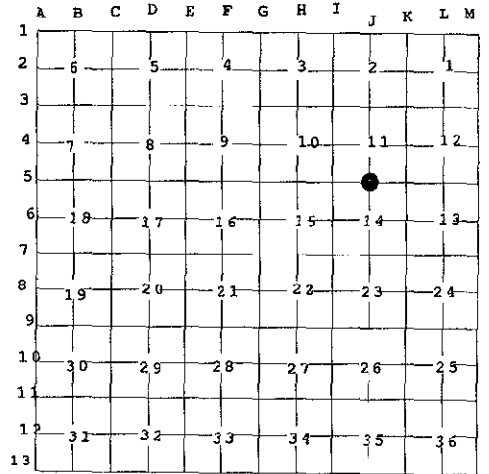

**NOTE: Not more than 2 corners, all in the same town and range, may be recorded on this certificate.**

**A. Description of original monument and accessories and/or subsequent restoration:**

- Set by John Brink in 1839
- Beech 6" N 13° W 19 links (Gone)
  - Hemlock 12" S 73° E 22 links (Gone)

**B. Description of corner evidence found and/or method applied in restoring or reestablishing corner:**

Information Referenced

County Surveyor Notes by William Manchester (1938) Page 75 of Book A

Slawinski Field Notes (1974)

Jefferson Addition to the City of Manistee recorded on January 9, 1956 in Liber 4 on Pages 19 & 20

- Found 1" iron pipe  
 Witnesses:
- N 30° W 68.98' Power Pole (Good)
  - N 25° E 87.27' 6" Spruce (Gone)
  - N 65° E 40.82' Power Pole (Gone)
  - N 40° E 7.88' 3" iron pipe (Good)

Field notes by Slawinski (1998) tie to Jefferson plat

On May 21, 1998, I Anthony Slawinski, along with Abonmarche found a 1" iron pipe, 6" below grade.

**C. Description of monument for corner and accessories established to perpetuate locating the position of the corner:**

On May 21, 1998, I installed a Manistee County Monument, 6" below grade, in the exact location of the above mentioned 1" iron pipe, as a careful and faithful re-establishment of the position of the original corner, and witnessed by:

- N 46° W 67.63' Power Pole, 60D spike in the Southwest side
- N 40° E ~~7.88~~ 3" iron pipe, ± 3' below grade
- N 53° E 33.49' Power Pole, 60D spike in the North side
- N 15° E 80.39' 7" Spruce, 60D spike in the West side
- N 85° E 104.09' 1 1/4" iron pipe, 12" above grade

Note: Corner is on the West side of Tamarack Street extended to the South. Said extended road is a maintenance road for the City of Manistee water wells. East 2642.94 feet to the Southeast Section Corner of Section 11, T22N., R17W.



Signed by Anthony M. Slawinski  
 Surveyor's Michigan License No. 13597

Date 6-1-98

Corner J-05  
 ratified by the Manistee County Peer Group according to the county plan adopted pursuant to P.A. 345 of 1990, as amended, (being the State Survey and Re monument Act, MCL 54.261 et seq.). Date of Peer Review: Anthony M. Slawinski 2 1998