

1993

COMMISSION

LAND CORNER RECORDATION CERTIFICATE
Filing Requirement of Act 74, Mich. P.A. 1970

For corners in
Manistee

(County)

Located in:

Corner Code #/

- 1. Public Land Survey T 21N R 17W J-7 (S 1/4 14)
T _____ R _____
T _____ R _____
T _____ R _____
- 2. Property Controlling S _____ T _____ R _____
in Section S _____ T _____ R _____
- 3. Miscellaneous S _____ T _____ R _____
Property in Sec. S _____ T _____ R _____

REGISTER'S OFFICE
MANISTEE COUNTY
93-702 at 11:51 AM
DEC 23 1993
Deborah Dix Dep.
REGISTER OF DEEDS

Register of Deeds Stamp & File Number

- 4. Lot No. _____, Recorded Plat _____
- 5. Private Claims _____

Bruce J. Jenema, in a field survey on Nov. 19, 19 93

I hereby certify that under requirements of P.A. 74, Michigan P.A. of 1970, the corner points mentioned in lines 1 and 2 above were in conformance with regulations and rules therefore as required in the current manual of survey instructions of the United States Department of the Interior, Bureau of Land Management or by a decree of a Court of Law and/or that the corner points mentioned in lines 3, 4 and 5 above were in conformance with the rules of the Michigan Board of Land Surveyors or by a Decree of a Court of Law; established, re-established, monumented, re-monumented, recovered, found as expressed below:

NOTE: Not more than 4 corners, all in the same town and range, may be recorded on this certificate.


	A	B	C	D	E	F	G	H	I	J	K	L	M
2	6	5	4	3	2	1							
3													
4	7	8	9	10	11	12							
5													
6	13	17	16	15	14	13							
7													
8	19	20	21	22	23	24							
9													
10	30	29	28	27	26	25							
11													
12	31	32	33	34	35	36							
13													

A. Description of original monument and accessories and/or subsequent restoration:

J-7 S 1/4 Corner Section 14
Originally established by the General Land Office Surveyor George Brink August 1839 Witness by: Beech 10" S43°E 18 links and Beech 10" N43°W 28 links
April 10, 1907 W.D. Manchester Set gas pipe Witness by: Norway 10" S05°E 52.8 ft. and Norway 9" N47°E 48.6 ft., Manistee County Surveyor Records, A.M. Slawinski 1983 Found Boat spike Witness by: SE NW corner of House 72.86 ft., NE SW Corner of House 88.05, SW 27.11 Power Pole, NW 10" Tri Maple 62.87 ft.

B. Description of corner evidence found and/or method applied in restoring or reestablishing corner:

J-7 Found Boat Spike over 2" pipe

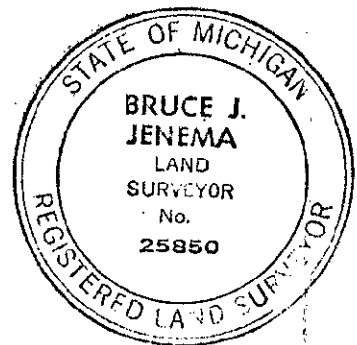

C. Description of monument for corner and accessories established to perpetuate locating the position of the corner:

J-7 South 1/4 corner of Section 14
Set 2"x30" Stainless Steel pipe with cap in monument Box
Replacing 2" pipe
Witness By:
Utility Pole S21°W 27.06 ft.
14" Spruce S53°E 51.10 ft.
14" Red Pine N23°W 54.25 ft.
Utility Pole N05°E 65.60 ft.

Corner J-07 ratified by the Manistee County Peer Group pursuant to P.A. 123 of 1915, as amended by P.A. 345 of 1990, as amended. Date of Peer Review: _____

APPROVED DEC 16 1993

Signed by *Bruce J. Jenema*
Surveyor's Michigan License No. 25850

Date November 30, 1993