

1993

LAND CORNER RECORDATION CERTIFICATE
Filing Requirement of Act 74, Mich. P.A. 1970

COMMISSION

REGISTER'S OFFICE
MANISTEE COUNTY
93-701 at 11:50 A.M.
DEC 23 1993

Deborah Dix, Dep.
REGISTER OF DEEDS

1. or corners in

Manistee

(County)

Located in:

Corner Code #

1. Public Land Survey	T	21	N	R	17	W	K-6
	T		R				
	T		R				
	T		R				
2. Property Controlling in Section	S		T		R		
	S		T		R		
3. Miscellaneous Property in Sec.	S		T		R		
	S		T		R		

Register of Deeds Stamp & File Number

4. Lot No. _____, Recorded Plat _____
Private Claims _____

	A	B	C	D	E	F	G	H	I	J	K	L	M
2	6	5		4		3		2		1			
3													
4	7	8	9	10	11	12							
5													
6	18	17	16	15	14	13							
7													
8	19	20	21	22	23	24							
9													
10	30	29	28	27	26	25							
11													
12	31	32	33	34	35	36							
13													

Bruce J. Jenema in a field survey on November 19, 1993
I hereby certify that under requirements of P.A. 74, Michigan P.A. of 1970, the corner points mentioned in lines 1 and 2 above were in conformance with regulations and rules therefore as required in the current manual of survey instructions of the United States Department of the Interior, Bureau of Land Management or by a decree of a Court of Law and/or that the corner points mentioned in lines 3, 4 and 5 above were in conformance with the rules of the Michigan Board of Land Surveyors or by a Decree of a Court of Law; established, re-established, monumented, re-monumented, recovered, found as expressed below:

NOTE: Not more than 4 corners, all in the same town and range, may be recorded on this certificate.

2. Description of original monument and accessories and/or subsequent restoration:


K-6 East 1/4 corner Section 14
Originally established by the General Land Office Surveyor George Brink August 1839 40 Chains intersect South boundary of Indian Reservation
Witness by: 14" W. Pine S50°W 52 links and 12" W. Oak S57°E 62 links
Manistee County surveyors records "33 ft. East and North of Fence corner".
A.M. Slawinski 7-29-83 Found 1/2" square iron S30°W 97.27 ft. 12" W. Pine, S45°E 42.37 ft. Telephone pole, N45°W 42.00 Power Pole, N55°E 79.83 ft. 12" Locust

3. Description of corner evidence found and/or method applied in restoring or reestablishing corner:

K-6 Found 1" square iron at the centerline intersections of Merkey and Maple Roads.

4. Description of monument for corner and accessories established to perpetuate locating the position of the corner:

K-6 East 1/4 corner of Section 14
Set 2"x30" stainless steel pipe with a brass cap in a monument box replacing 1" square iron
Witness by:
Utility Pole N36°W 41.90 ft.
Utility Pole N28°E 98.09 ft.
Utility Pole S24°W 116.15 ft.
Spruce N65°E 59.72 ft.

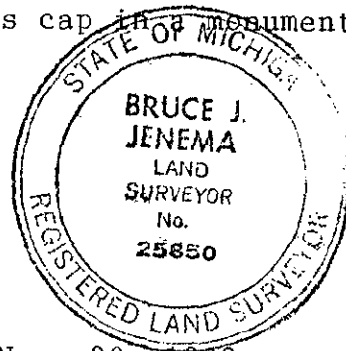

Corner K-6 617K6 ratified by the Manistee County Peer Group pursuant to P.A. 123 of 1915, as amended by P.A. 345 of 1990, as amended. Date of Peer Review: 6/19/93
APPROVED DEC 6 1993

Signed by *Bruce J. Jenema*
Surveyor's Michigan License No. 25850

Date Nov. 29, 1992