

SURVEY & REMONUMENTATION

JUL 14 1994

COMMISSION

LAND CORNER RECORDATION CERTIFICATE
 Filing Requirement of Act 74, Mich. P.A. 1970

For corners in

MANISTEE
 (County)

Located In:

Corner Code #

- | | | | | | |
|------------------------------------|---|-----|---|-----|-----|
| 1. Public Land Survey | T | 21N | R | 17W | K-8 |
| | T | | R | | |
| | T | | R | | |
| | T | | R | | |
| 2. Property Controlling in Section | S | | T | R | |
| | S | | T | R | |
| 3. Miscellaneous Property in Sec. | S | | T | R | |
| | S | | T | R | |
4. Lot No. _____, Recorded Plat _____
5. Private Claims _____

REGISTER'S OFFICE
 MANISTEE COUNTY

#94-257 AT 10:40 A.M.

JUN 15 1994

Penny A. Pedraza
 REGISTER OF DEEDS

Register of Deeds Stamp & File Number

I, Sammy S. Barnett, in a field survey on APRIL, 1994, do hereby certify that under requirements of P.A. 74, Michigan P.A. of 1970, the corner points mentioned in lines 1 and 2 above were in conformance with regulations and rules therefore as required in the current manual of survey instructions of the United States Department of the Interior, Bureau of Land Management or by a decree of a Court of Law and/or that the corner points mentioned in lines 3, 4 and 5 above were in conformance with the rules of the Michigan Board of Land Surveyors or by a Decree of a Court of Law; established, re-established, monumented, re-monumented, recovered, found as expressed below:

NOTE: Not more than 4 corners, all in the same town and range, may be recorded on this certificate.

A. Description of original monument and accessories and/or subsequent restoration:

K-8 1/4 corner, Sec's., 23 & 24, T21N,R17W.

1839, John Brink D.S., G.L.O. Page 419

Used W. Pine for corner

E W

April 10, 1907, . . . Muenscher Book A P 77

Notes a fence corner 2 rods (33') East of corner.

B. Description of corner evidence found and/or method applied in restoring or reestablishing corner:

K-8 1/4 corner, Sec's., 23 & 24, T21N,R17W.

On April 22, 1994, found 1" Iron Pipe with R.L.S. cap (can't read), . . . 1' West of center-line of Map Road, just below the road surface.

C. Description of monument for corner and accessories established to perpetuate locating the position of the corner:

K-8 1/4 corner, Sec's., 23 & 24, T21N,R17W.

(OBT) Red Oak 22" N 79° W 46.35' (60d spike over dhn with shiner SE side of tree)

(OBT) W. Oak 15" S 83° W 54.15' (60d spike over dhn with shiner NE side of tree)

W. Oak 10" S 45° E 61.22' (60d spike in NE side of tree)


Twin Willow 22" N 65 ° E 68.09' (60d spike in NW side of tree)

Replaced 1" Iron Pipe with a Manistee County monument (2½" x 30" steel pipe with brass cap), placed in a monument box, and is accepted as a careful and faithful reestablishment of the position of the original corner.

Signed by Sammy S. Barnett

Date 6/3/94

Surveyor's Michigan License No. 16923

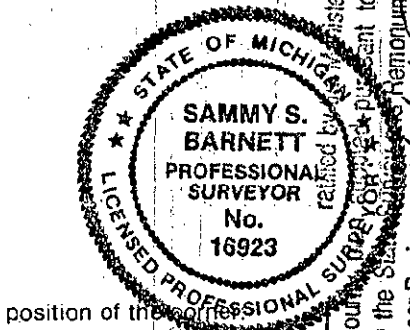

Manistee County Peer Group
 Peer Review
 P.A. 345 of 1990,
 as amended, (being the State of Michigan's Remonument Act, MCL 54.261,
 et. seq.) . Date of Peer Review: 6/6/94 *Cathleen P. [Signature]*

	A	B	C	D	E	F	G	H	I	J	K	L	M
2	6		5		4		3		2		1		
3													
4	7		8		9		10		11		12		
5													
6	18		17		16		15		14		13		
7													
8	19		20		21		22		23		24		
9													
10	30		29		28		27		26		25		
11													
12	31		32		33		34		35		36		
13													