SURVEY & REMONUMENTATION

JUL 1 4 1994

COMMISSION

LAND CORNER RECORDATION CERTIFICATE

Filing Requirement of Act 74, Mich. P.A. 1970

REGISTER'S OFFICE
MANISTEE COUNTY
#94-256 AT 10:37 A.M.
JUN 1 5 1994
Penny A. Pease
REGISTER OF DEEDS

Register of Deeds Stamp & File Number

For corners in

MANISTEE (County)

	Located In:	Corner Code #
1. Public Land Survey	T 21N R 17W	K-9
	T ___ R ___	
	T ___ R ___	
	T ___ R ___	
2. Property Controlling	S ___ T ___ R ___	
in Section	S ___ T ___ R ___	
3. Miscellaneous	S ___ T ___ R ___	
Property in Sec.	S ___ T ___ R ___	

4. Lot No. _____, Recorded Plat _____
5. Private Claims _____

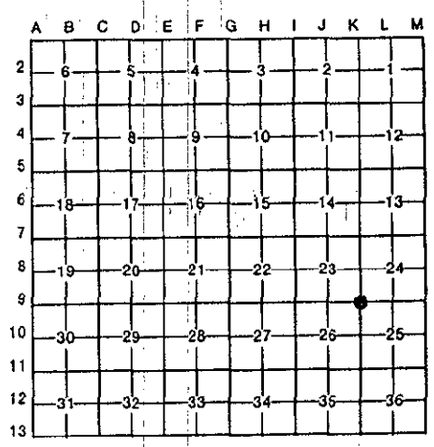

I, Sammy S. Barnett, in a field survey on APRIL, 19 94, do hereby certify that under requirements of P.A. 74, Michigan P.A. of 1970, the corner points mentioned in lines 1 and 2 above were in conformance with regulations and rules therefore as required in the current manual of survey instructions of the United States Department of the Interior, Bureau of Land Management or by a decree of a Court of Law and/or that the corner points mentioned in lines 3, 4 and 5 above were in conformance with the rules of the Michigan Board of Land Surveyors or by a Decree of a Court of Law; established, re-established, monumented, re-monumented, recovered, found as expressed below:

NOTE: Not more than 4 corners, all in the same town and range, may be recorded on this certificate.

A. Description of original monument and accessories and/or subsequent restoration:

K-9 Section corner, Sec's., 23,24,25 & 26, T21N,R17W.

1839, John Brink D.S. G.L.O. Page 419
Set wood post
#1 Maple 8" S 60° W 91k. (5.94')
#2 W. Pine 10" S 22° E 101k. (6.60')

B. Description of corner evidence found and/or method applied in restoring or reestablishing corner:

K - 9 Section corner, Sec's., 23,24,25 & 26, T21N,R17W.

On May 3, 1994 found a Rail Road Spike in center-line of Maple Road .1' below road surface, also found witnesses to Rail Road Spike, a pine guard rail with double head nail w/ shiner S 75° E, 16.90', dhn. shiner, in rail N 23° E, 48.00' and dhn w/ shiner, in rail, N 52° W, 21.83'
Condition of record witnesses are; #1 Gone #2 Gone

NOTE; Found 11/4" Iron Pipe under 12" Railroad spike.

Corner K - 9 - ratified by the Manistee County Peer Group according to the county plan adopted pursuant to P.A. 345 of 1990, as amended, (being the State Survey and Remonument Act, MCL 54.261 et. seq.). Date of Peer Review: 6/6/94

C. Description of monument for corner and accessories established to perpetuate locating the position of the corner:

K-9 Section corner, Sec's., 23,24,25 & 26, T21N,R17W.

Replaced Rail Road Spike with a Manistee County monument (2½" x 30" steel pipe with brass cap), placed in a monument box, and is accepted as a careful and faithful reestablishment of the position of the original corner.

W. Pine 12" N 49° E 260.46' (60d spike in SE side of tree)
W. Pine 13" S 79° E 163.97' (60d spike in NE sidr of tree)
W. Pine 5" S 56° W 107.55' (60d spike in SE side of tree)
Power Pole (w-77) N 03° W 331.69' (60d spike in East side of tree)

STATE OF MICHIGAN
SAMMY S. BARNETT
PROFESSIONAL SURVEYOR
No. 16923
LICENSED PROFESSIONAL SURVEYOR

Signed by Sammy S. Barnett Date 6/3/94

Surveyor's Michigan License No. 16923

FORM APPROVED BY MICHIGAN STATE BOARD OF LAND SURVEYORS, JAN. 28, 1971
REVISED MAY 14, 1975
REVISED JAN., 1983