

**SURVEY &
REMONUMENTATION**

JUL 14 1994

COMMISSION

**LAND CORNER RECORDATION CERTIFICATE
Filing Requirement of Act 74, Mich. P.A. 1970**

For corners in

<u>MANISTEE</u> (County)	Located In:	Corner Code #
1. Public Land Survey	T <u>21N</u> R <u>17W</u>	<u>K-10</u>
	T _____ R _____	_____
	T _____ R _____	_____
	T _____ R _____	_____
2. Property Controlling in Section	S _____ T _____ R _____	_____
	S _____ T _____ R _____	_____
3. Miscellaneous Property in Sec.	S _____ T _____ R _____	_____
	S _____ T _____ R _____	_____
4. Lot No. _____, Recorded Plat _____		
5. Private Claims _____		

REGISTER'S OFFICE
MANISTEE COUNTY
94-255 AT 10:33 A.M.
JUN 15 1994
Permy A. Permy
REGISTER OF DEEDS

Register of Deeds Stamp & File Number

I, Sammy S. Barnett, in a field survey on APRIL, 1994, do hereby certify that under requirements of P.A. 74, Michigan P.A. of 1970, the corner points mentioned in lines 1 and 2 above were in conformance with regulations and rules therefore as required in the current manual of survey instructions of the United States Department of the Interior, Bureau of Land Management or by a decree of a Court of Law and/or that the corner points mentioned in lines 3, 4 and 5 above were in conformance with the rules of the Michigan Board of Land Surveyors or by a Decree of a Court of Law; established, re-established, monumented, re-monumented, recovered, found as expressed below:

NOTE: Not more than 4 corners, all in the same town and range, may be recorded on this certificate.

A. Description of original monument and accessories and/or subsequent restoration:

K-10 1/4 corner, Sec., 25 & 26, T21N,R17W.

1839, John Brink D.S., G.L.O. Page 419
Set Wood Post
#1 Beech 8" N 13° E 221k. (14.52')
#2 W. Pine 10" S 25° W 161k. (10.56')

B. Description of corner evidence found and/or method applied in restoring or reestablishing corner:

K-10 1/4 corner, Sec., 25 & 26, T21N,R17W.


On April 22, 1994, found a 1½" Iron Pipe with R.L.S. cap (can't read center with P.K. nail, flush with road surface and 3 feet East of the center-line of Maple Road. Also found 1" Iron Pipe with R.L.S. cap (Tony Slawinski, #13597), 33 feet East of Corner.
Condition of record witnesses are; #1 Gone #2 Gone

C. Description of monument for corner and accessories established to perpetuate locating the position of the corner:

K-10 1/4 corner, Sec., 25 & 26, T21N,R17W.

Replaced 1½" Iron Pipe with a Manistee County monument (2½" x 30" steel pipe with brass cap), placed in a monument box, and is accepted as a careful and faithful reestablishment of the position of the original corner.
(OBT) Tri. W. Oak 14" N 58° W 61.20' (60d spike over brass nail with shiner in NE side of tree)
W. Pine 10" N 50° E 51.73' (60d spike in SE side of tree)
W. Oak 10" S 67° E 52.77' (60d spike in SW side of tree)
Bl. Oak 5" S 77° W 48.68' (60d spike in SE side of tree)

A	B	C	D	E	F	G	H	I	J	K	L	M
2	6	5	4	3	2	1						
3												
4	7	8	9	10	11	12						
5												
6	18	17	16	15	14	13						
7												
8	19	20	21	22	23	24						
9												
10	30	29	28	27	26	25						
11												
12	31	32	33	34	35	36						
13												

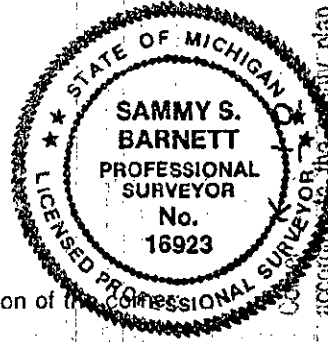

ratified by the Manistee County Peer Group
 as amended, (being the State Survey and Remonument Act, MCL 54.261
 et seq.). Date of Peer Review: 6/6/94 *William R. ...*

Signed by *Sammy S. Barnett* Date 6/3/94
 Surveyor's Michigan License No. 16923