

JUL 14 1994

COMMISSION

LAND CORNER RECORDATION CERTIFICATE
Filing Requirement of Act 74, Mich. P.A. 1970

For corners in

MANISTEE (County)

Located In:

Corner Code =#

1. Public Land Survey

T 21N R 17W

K-11

2. Property Controlling in Section

S T R

3. Miscellaneous Property in Sec.

S T R

4. Lot No. , Recorded Plat

5. Private Claims

REGISTER'S OFFICE MANISTEE COUNTY

94-254 AT 10:30 A.M.

JUN 15 1994

Penny A. Peters REGISTER OF DEEDS

Register of Deeds Stamp & File Number

Grid table with columns A-M and rows 2-13. A dot is marked at the intersection of column J and row 11.

I, Sammy S. Barnett, in a field survey on APRIL, 1994

do hereby certify that under requirements of P.A. 74, Michigan P.A. of 1970, the corner points mentioned in lines 1 and 2 above were in conformance with regulations and rules therefore as required in the current manual of survey instructions of the United States Department of the Interior, Bureau of Land Management or by a decree of a Court of Law and/or that the corner points mentioned in lines 3, 4 and 5 above were in conformance with the rules of the Michigan Board of Land Surveyors or by a Decree of a Court of Law; established, re-established, monumented, re-monumented, recovered, found as expressed below:

NOTE: Not more than 4 corners, all in the same town and range, may be recorded on this certificate.

A. Description of original monument and accessories and/or subsequent restoration:

K-11 Section corner, Sec's., 25,26,35 & 36, T21N,R17W.

1839, John Brink D.S., G.L.O. Page 418 Set Wood Post

#1 Beech 6" S 82° W 191k. (12.54') #2 Beech 8" N 50° E 181k. (11.88')

August 3, 1893, E. W. Muenscher Book A Page 78 Found stake set by W. H. Cooke

#3 Beech 14" N 04 1/2° W 771k. (50.82')

B. Description of corner evidence found and/or method applied in restoring or reestablishing corner:

K-11 Section corner, Sec's., 25,26,35 & 36, T21N,R17W.

On April 22, 1994, found a rail road spike flush with road surface and at the intersection of Maple Road and Fox Farm Road. Did not find any conflicting evidence to deny location of corner. Condition of record witnesses are; #1 Gone #2 Gone #3 Gone

C. Description of monument for corner and accessories established to perpetuate locating the position of the corner:

K-11 Section corner, Sec's., 25,26,35 & 36, T21N,R17W.


Replaced Rail Road Spike with a Manistee County monument (2 1/2" x 30" steel pipe with brass cap), placed in a monument box, and is accepted as a careful and faithful reestablishment of the position of the original corner.

(OBT) Power Pole S 50° E 44.08' (60d spike over 16p nail with shiner in NE side of pole) Power Pole N 44° E 44.85' (60d spike in NW side of pole) R. Pine 13" S 48° W 74.10' (60d spike in NW side of tree) W. Birch 9" N 31° W 83.19' (60d spike SW side of tree)

Signed by Sammy S. Barnett

Date 6/3/94

Surveyor's Michigan License No. 16923

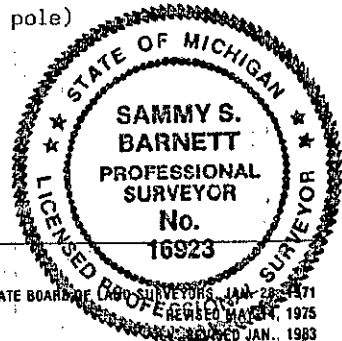

Corner XI - - - - - ratified by the Manistee County Peer Group according to the county plan adopted pursuant to P.A. 345 of 1990, as amended, (being the State Survey and Remonumentation Act, Mich. P.A. 54,281 (S.L.S.G.)). Date of Peer Review: 6/6/94