

LAND CORNER RECORDATION CERTIFICATE

Filing Requirement of Act 74, Mich. P.A. 1970

For corners in  
MANISTEE

Located In:

Corner Code #

REGISTER'S OFFICE  
MANISTEE COUNTY

98-262 (1-110)  
JUL 01 1998

*Richard L. Hays*  
REGISTER OF DEEDS

Register of Deeds Stamp & File Number

1. Public Land Survey T 21N R 17W M-13 ✓  
T 21N R 16W A-13  
T R  
T R  
2. Property Controlling S T R  
in Section S T R  
3. Miscellaneous S T R  
Property in Sec. S T R

4. Lot No. \_\_\_\_\_, Recorded Plat \_\_\_\_\_  
5. Private Claims \_\_\_\_\_

I, Richard L. Hays, in a field survey on April 1998, do hereby certify that under requirements of P.A. 74, Michigan P.A. of 1970, the corner points mentioned in lines 1 and 2 above were in conformance with regulations and rules therefore as required in the current manual of survey instructions of the United States Department of the Interior, Bureau of Land Management or by a decree of a Court of Law and/or that the corner points mentioned in lines 3, 4 and 5 above were in conformance with the rules of the Michigan Board of Land Surveyors or by a Decree of a Court of Law; established, re-established, monumented, re-monumented, recovered, found as expressed below:

1	A	B	C	D	E	F	G	H	I	J	K	L	M
2	6	5	4	3	2	1							
3													
4	7	8	9	10	11	12							
5													
6	18	17	16	15	14	13							
7													
8	19	20	21	22	23	24							
9													
10	30	29	28	27	26	25							
11													
12	31	32	33	34	35	36							
13													

NOTE: Not more than 4 corners, all in the same town and range, may be recorded on this certificate.


A. Description of original monument and accessories and/or subsequent restoration:  
SOUTHEAST QUARTER CORNER OF SECTION 36, T21N-R17W  
1838: G.L.O. Survey by John Brink Set post. 14" W. Pine N-67-1/2°-E 29 Lks(1)  
10" Beech N-88°-W 34 Lks(2)  
1968: K.B. Stephens C.P.C. Fd. 1/2" Pipe  
Power Pole S-71°-W 96.05' (3)  
Telephone Pole N-52°-W 42.72' (4)  
16" White Oak N-26°-W 83.06' (5)  
NE Cor Store S-11°-E 40.02' (6)  
1974: Hebert L. Fluharty Fd. P.K. Nail  
22" Oak N-28°-W 83.13' (5)  
Power Pole S-70°-W 95.43' (3)  
NE Cor Store S-14°-E 40.00' (6)  
1983: Lawrence Slatwer L.C.R.C. 83-11  
Found 1/2" Pipe  
NW Cor Bldg S-10°-W 47.27' (7)  
Power Pole S-75°-W 95.24' (3)  
S. Fence Cor N-60°-W 68.24' (8)  
24" Oak N-25°-W 83.41' (5)  
1994: Jenema Surveys Act 132 Liber 2, Page 567  
22" Oak N-28°-W 83.13' (5)  
Power Pole S-70°-W 95.43' (3)  
NE Cor Store S-14°-E 40.00' (6)

B. Description of corner evidence found and/or method applied in restoring or reestablishing corner:  
SOUTHEAST QUARTER CORNER OF SECTION 36, T21N-R17W  
APRIL 1998: Found 1/2" Pipe. Condition of the witnesses are as follows:  
14" W. Pine N-67-1/2°-E 29 Lks (1) GONE  
10" Beech N-88°-W 34 Lks (2) GONE  
Power Pole S-71°-W 96.05' (3) GONE  
Telephone Pole N-52°-W 42.72' (4) GONE  
16" White Oak N-26°-W 83.06' (5) FOUND  
NE Cor Store S-11°-E 40.02' (6) FOUND  
SW Cor Bldg S-10°-W 47.27' (7) FOUND  
S. Fence Cor N-60°-W 68.24' (8) GONE

C. Description of monument for corner and accessories established to perpetuate locating the position of the corner:  
SOUTHEAST QUARTER CORNER OF SECTION 36, T21N-R17W  
APRIL 1998: Accepted 1/2" Pipe and replaced with a MANISTEE COUNTY MONUMENT with Monument Box as the best available evidence of the position of the Corner.  
Power Pole N-64°-W 93.64' 60 Penny Nail  
Power Pole S-76°-W 95.34' (3) 60 Penny Nail  
NE Cor Garage S-06°-E 39.86' (6) 60 Penny Nail  
30" White Oak N-28°-W 83.42' (5) 60 Penny Nail  
Southeast Corner 122.96' West of the Centerline of US 31

Corner M-13 ratified by the Manistee County Peer Group according to the county plan adopted pursuant to P.A. 345 of 1990, amended. (being the State Survey and Remonument Act, MCL 54.261 Date of Peer Review: MAY 5 1998

Signed by Richard Hays  
Surveyor's Michigan License No. 25847

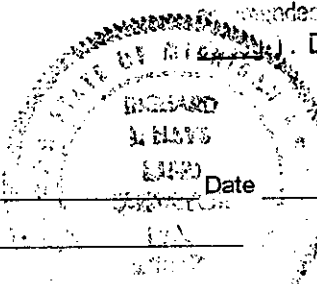

Date May 1, 1998  
*Anthony M. Slawinski*