Manistee County
Manistee County Courthouse • 415 Third Street • Manistee, Michigan 49660

REMONUMENTATION
c/o PLANNING DEPARTMENT
(616)723-6041

T22N-R13W; east part, Dickson Township
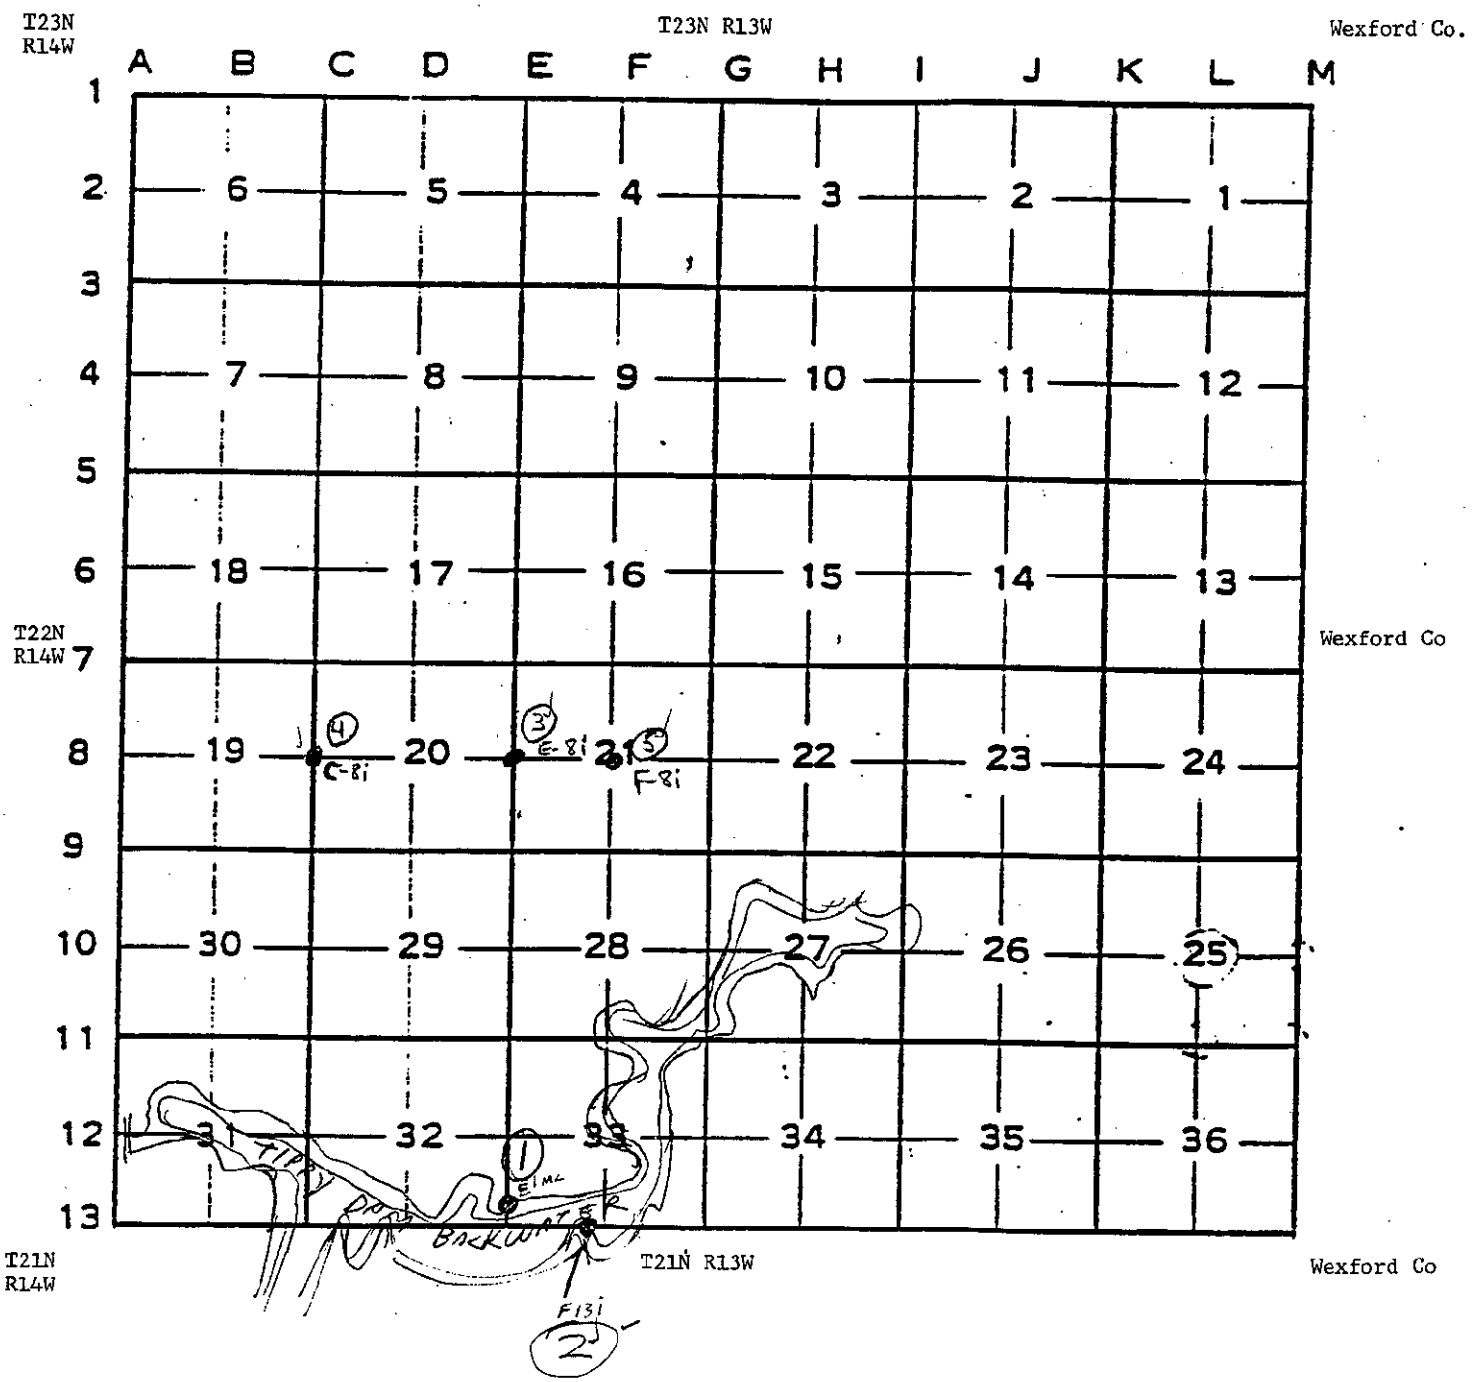
TOWNSHIP CORNER NUMBERING CODE DIAGRAM