

LAND CORNER RECORDATION CERTIFICATE
Filing Requirement of Act 74, Mich. P.A. 1970

For corners in

<u>MANISTEE</u> (County)	Located In:	Corner Code #/1
1. Public Land Survey	T 22N R 13W	E-5
	T _____ R _____	
	T _____ R _____	
2. Property Controlling in Section	S 16 T 22N R 13W	16-3
	S _____ T _____ R _____	
3. Miscellaneous Property in Sec.	S _____ T _____ R _____	
	S _____ T _____ R _____	
4. Lot No. _____, Recorded Plat _____		
5. Private Claims _____		

REGISTER'S OFFICE
MANISTEE COUNTY
#93-576 AT 4:42 p.m.
OCT 5 1993

Penny A. Pepera
REGISTER OF DEEDS

Register of Deeds Stamp & File Number

I, Norman C. Caldwell, in a field survey on _____ November, 191_____, do hereby certify that under requirements of P.A. 74, Michigan P.A. of 1970, the corner points mentioned in lines 1 and 2 above were in conformance with regulations and rules therefore as required in the current manual of survey instructions of the United States Department of the Interior, Bureau of Land Management or by a decree of a Court of Law and/or that the corner points mentioned in lines 3, 4 and 5 above were in conformance with the rules of the Michigan Board of Land Surveyors or by a Decree of a Court of Law; established, re-established, monumented, re-monumented, recovered, found as expressed below:

NOTE: Not more than 4 corners, all in the same town and range, may be recorded on this certificate.


A	B	C	D	E	F	G	H	I	J	K	L	M
2	6	5	4	3	2	1						
3												
4	7	8	9	10	11	12						
5												
6	18	17	16	15	14	13						
7												
8	19	20	21	22	23	24						
9												
10	30	29	28	27	26	25						
11												
12	31	32	33	34	35	36						
13												

A. Description of original monument and accessories and/or subsequent restoration:

E-5	<u>Sec. cor., 8, 9, 16 & 17</u>	16-3	<u>N 1/16, Sec. 16 & 17</u>
	Post placed by John Brink in 1839 subdivision survey.		This position not established by original government survey.
	N38°E 13 lks. (8.6') 14" White Pine		
	S80°W 25 lks. (16.5') 11" White Pine		

B. Description of corner evidence found and/or method applied in restoring or reestablishing corner:

E-5	<u>Sec. cor., 8, 9, 16 & 17</u>	16-3	<u>N 1/16, Sec. 16 & 17</u>
	Found 4" conc. monument w/rebar by Richards L.S. #11183.		Found 1 1/8" axle shaft midway and on-line by Richards, L.S. #11183.
	N85°W 13.06' 10" Oak		S55°E 34.02' 30" Oak
	N60°E 20.01' 12" Oak		N70°E 32.84' 6" Oak
	S25°E 7.87' 6" Oak		West 25.15' 12" Oak

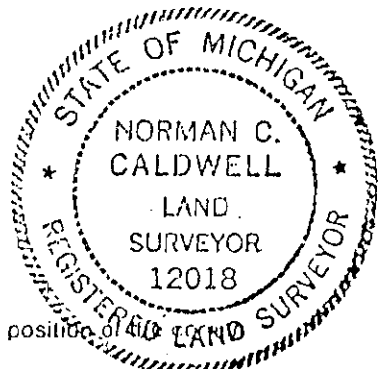

C. Description of monument for corner and accessories established to perpetuate locating the position of corner:

E-5	<u>Sec. cor., 8, 9, 16 & 17, T22N-R13W</u>	16-3	<u>N 1/16, Sec. 16 & 17, T22N-R13W</u>
	Found 4" conc. monument and replaced with 2" x 30" stainless steel monument and is accepted as the best available evidence of the position of the original corner.		Found 1 1/8" axle shaft. This position not established by original government survey. This monument is accepted as a careful and faithful determination of the position of the corner.
	N85°W 13.10' 12" Oak		West 25.12' 14" Oak
	S25°E 7.87' 8" Oak		N80°E 33.19' 8" Oak
	N60°E 20.09' 14" Oak		S35°E 48.85' 10" Oak
	N13°W 22.97' 8" Maple		N20°W 71.10' 8" Oak
	West 1.1' Carsonite Witness Post		West 10.0'± CL N-S road
	N80°E 45.15' 12" Oak		East 6.0' Carsonite Witness Post

Signed by *Norman C. Caldwell* Date 9 JAN 1992
Surveyor's Michigan License No. 12018

Corner E-5 ratified by the Manistee County Peer Group pursuant to P.A. 123 of 1915, as amended by P.A. 345 of 1930 and P.A. 348 of 1930.