LAND CORNER RECORDATION CERTIFICATE

Filing Requirement of Act 74, Mich. P.A. 1970

For corners in

MANISTEE (County)

	Located In:	Corner Code ##
1. Public Land Survey	T 22N R 13W	E-6 E-7
	T ___ R ___	
	T ___ R ___	
	T ___ R ___	
2. Property Controlling	S ___ T ___ R ___	
in Section	S ___ T ___ R ___	
3. Miscellaneous	S ___ T ___ R ___	
Property in Sec.	S ___ T ___ R ___	

REGISTER'S OFFICE
MANISTEE COUNTY
#93-575 At 4:40 p.m.
OCT 5 1993
Penny A. Pearce
REGISTER OF DEEDS

Register of Deeds Stamp & File Number

4. Lot No. ___, Recorded Plat ___
5. Private Claims ___

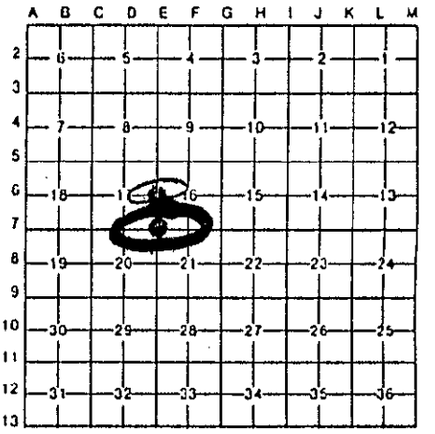

I, Norman C. Caldwell, in a field survey on November, 191, do hereby certify that under requirements of P.A. 74, Michigan P.A. of 1970, the corner points mentioned in lines 1 and 2 above were in conformance with regulations and rules therefore as required in the current manual of survey instructions of the United States Department of the Interior, Bureau of Land Management or by a decree of a Court of Law and/or that the corner points mentioned in lines 3, 4 and 5 above were in conformance with the rules of the Michigan Board of Land Surveyors or by a Decree of a Court of Law; established, re-established, monumented, re-monumented, recovered, found as expressed below:

NOTE: Not more than 4 corners, all in the same town and range, may be recorded on this certificate.

A. Description of original monument and accessories and/or subsequent restoration:

E-6 1/4 cor., Sec. 16 & 17

Post placed by John Brink in 1839 subdivision survey.
S61°W 10 lks. (6.6') 14" White Pine
N70°E 12 lks. (7.9') 12" Maple

E-7 Sec. cor., 16, 17, 20 & 21

Post placed by John Brink in 1839 subdivision survey.
S22°E 26 lks. (17.2') 8" Beech
S54°W 27 lks. (17.8') 8" Maple

B. Description of corner evidence found and/or method applied in restoring or reestablishing corner:

E-6 1/4 cor., Sec. 16 & 17

Found ½" rebar placed by Clinton Cole, #17615 in 1981.
N04°W 54.37' 4" Sq. Post
N57°W 56.60' 4" Sq. Post
S70°W 116.73' Power Pole

E-7 Sec. cor., 16, 17, 20 & 21

Found 1" iron pipe by Blass in 1969.
S24°E 32.7' 10" Twin Maple
S67°E 50.4' 14" Red Oak
S65°W 33.5' 8" White Oak

STATE OF MICHIGAN NORMAN C. CALDWELL PROFESSIONAL SURVEYOR No. 12018 REGISTERED PROFESSIONAL SURVEYOR

16 SEPT 93

STATE OF MICHIGAN NORMAN C. CALDWELL LAND SURVEYOR 12018 REGISTERED LAND SURVEYOR

C. Description of monument for corner and accessories established to perpetuate locating the position of the corner:

E-6 1/4 cor., Sec. 16 & 17, T22N-R13W

Found ½" bar w/17615 cap and placed 5" x 36" conc. monumentand is accepted as the best available evidence of the position of the corner.
S70°W 116.73' Power Pole (R)
S25°E 63.13' 12" Poplar
N04°W 54.32' 4" sq. post #5022 (R)
N57°W 56.60' 4" sq. post stop sign (R)
N45°E 30.0' Carsonite Witness Post
South 18.0'± CL blt E-W
West 24.0'± CL gravel North
N07°E 75.15' 6" Maple
N53°W 100.73' 10" Oak

E-7 Sec. cor., 16, 17, 20 & 21, T22N-R13W

Found 1" iron pipe and placed 2½" x 30" stainless steel monument and is accepted as the best available evidence of the position of the original corner.
N80°W 22.90' 12" Oak
S30°W 25.02' 8" Oak
N70°E 33.56' group 6" - 8" Maple
N10°E 25.16' 12" Oak
North 0.58' Carsonite Witness Post

Signed by Norman C. Caldwell Date 9 JAN 1992

Surveyor's Michigan License No. 12018

Corner E-6 & E-7 ratified by the Manistee County Peer Group pursuant to P.A. 125 of 1915, as amended by P.A. 345 of 1990, as
Date of Peer Review: 9 1993

FORM APPROVED BY MICHIGAN STATE BOARD OF LAND SURVEYORS, JAN. 28, 1971
REVISED MAY 14, 1975
REVISED JAN., 1983