

LAND CORNER RECORDATION CERTIFICATE
Filing Requirement of Act 74, Mich. P.A. 1970

DEC 09 1999

For corners in SECTION
MANISTEE
 (County)

Located In:

Corner Code #

- 1. Public Land Survey

T 23N	R 13W	G-13
T 22N	R 13W	G-01
T	R	
T	R	
- 2. Property Controlling in Section

S	T	R
S	T	R
- 3. Miscellaneous Property in Sec.

S	T	R
S	T	R
- 4. Lot No. _____, Recorded Plat _____
- 5. Private Claims _____

REGISTER'S OFFICE
MANISTEE COUNTY
 99-289 at 11:55AM
SEP - 9 1999
Deborah Dix
REGISTER OF DEEDS

Register of Deeds Stamp & File Number

	A	B	C	D	E	F	G	H	I	J	K	L
1												
2	6	5	4	3	2	1						
3												
4	7	8	9	10	11	12						
5												
6	18	17	16	15	14	13						
7												
8	19	20	21	22	23	24						
9												
10	30	29	28	27	26	25						
11												
12	31	32	33	34	35	36						
13												

I, Kenneth L. Ross, in a field survey on May 28 19 99, do hereby certify that under requirements of P.A. 74, Michigan P.A. of 1970, the corner points mentioned in lines 1 and 2 above were in conformance with regulations and rules therefore as required in the current manual of survey instructions of the United States Department of the Interior, Bureau of Land Management or by a decree of a Court of Law and/or that the corner points mentioned in lines 3, 4 and 5 above were in conformance with the rules of the Michigan Board of Land Surveyors or by a Decree of a Court of Law; established, re-established, monumented, re-monumented, recovered, found as expressed below:

NOTE: Not more than 4 corners, all in the same town and range, may be recorded on this certificate.

A. Description of original monument and accessories and/or subsequent restoration:

- G-13 Section Corner for Sections 33 & 34, T23N-R13W, Standard corner on T.L.
- G-01 Section Corner for Sections 3 & 4, T22N R13W, Closing corner on Township line.

- 1838, John Brink, G.L.O., Boundary Survey
 Set Post
 #1 White Pine 10" N 42-30' E 37 lks. (24.42')
 #2 Black Oak 13" N 29-30' W 35 lks. (23.10')
- 1839, John Brink, G.L.O. Interior Survey (closing corner)
 Intersected North boundary at Post-81.80 chs.
 #3 Beech 10" S 34 E 44 lks. (29.14')
 #4 White Oak 11 S 03 W 62 lks. (40.92')
- 1909, Fargo Eng. (Consumer Power Co.)
 Found New Stake & G.L.O. witnesses trees
 Set 1" Iron Pipe, with Lime around pipe.
 #5 White Pine Stp. 34" S 54 W 39.60' (0.6 chs.)
 #6 White Pine Stp. 34" S 82 E 29.70' (0.45 chs.)

- 1986, Robert A. Griffin, RLS #13584
 Found 1 1/4" Iron Pipe from Fargo's witnesses & took 3 new witnesses.
- #7 Red Oak 6" N 36 W 17.88'
- #8 Red Oak 12" N 11 E 18.75'
- #9 White Oak 10" N 83 E 24.68'
 Liber 87 pg. 85

B. Description of corner evidence found and/or method applied in restoring or reestablishing corner:

- G-13 Section Corner for Sections 33 & 34, T23N-R13W.
- G-01 Section Corner for Sections 3 & 4, T22N R13W.

On May 28, 1999, I found a 1" Iron Pipe, on an old fence line, that's down. We dug up the Pipe and all found traces of lime, from Fargo Eng.

- Condition of witnesses
- #1 found remains of pine stump
 - #2 gone
 - #3 gone
 - #4 gone
 - #5 found good
 - #6 found good
 - #7 found good

- #8 found in good condition
- #9 found good, 10" W.O. spk in NW side


Corner --- ratified by the Manistee County Peer Group according to the county plan adopted pursuant to P.A. 345 of 1990, as amended, (being the State Survey and Remonument Act, MCL 54.261 et seq.). Date of Peer Review: Anthony M. Sawicki

- C. Description of monument for corner and accessories established to perpetuate locating the position of the corner:**
- G-13 Section Corner for Sections 33 & 34, T23N-R13W, Standard corner on the township line
 - G-01 Section Corner for Sections 3 & 4, T22N R13W, Closing corner on the Township line

SEP 07 1999

I set a standard Manistee County monument stamped to identify the corner, in the exact location, of found 1" Iron pipe by Fargo, monument was placed 0.3' above the ground, this corner is accepted as a faithful and faithful perpetuation the the position of the original corner.

- ext. BT #7 Red Oak 6" N36W 18.57' (set 60d spike in SW side of tree)
- ext. BT #8 Red Oak 13" N11E 19.35' (set 60d spike in NW side of tree)
- ext. BT #9 White Oak 10" N83E 25.23' (fd 60d spike in NW side of tree)
- new BT White Oak 14" S64E 13.84' (set 60d spike in SW side)

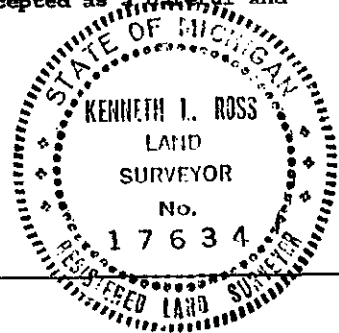

Signed by Kenneth L. Ross
 Surveyor's Michigan License No. 17634

Date 9-7-99