

**LAND CORNER RECORDATION CERTIFICATE**  
**Filing Requirement of Act 74, Mich. P.A. 1970**


For corners in

<u>MANISTEE</u> (County)	Located In:	Corner Code #/4
1. Public Land Survey	T <u>22N</u> R <u>13W</u>	<u>G-5</u> G-6
	T _____ R _____	_____
	T _____ R _____	_____
	T _____ R _____	_____
2. Property Controlling in Section	S _____ T _____ R _____	_____
	S _____ T _____ R _____	_____
3. Miscellaneous Property in Sec.	S _____ T _____ R _____	_____
	S _____ T _____ R _____	_____

REGISTER'S OFFICE  
 MANISTEE COUNTY  
 #93-579 AT 4:49 PM.  
**OCT 5 1993**  
*Penny A. Posa*  
 REGISTER OF DEEDS

Register of Deeds Stamp & File Number

4. Lot No. \_\_\_\_\_, Recrded Plat \_\_\_\_\_  
 5. Private Claims \_\_\_\_\_

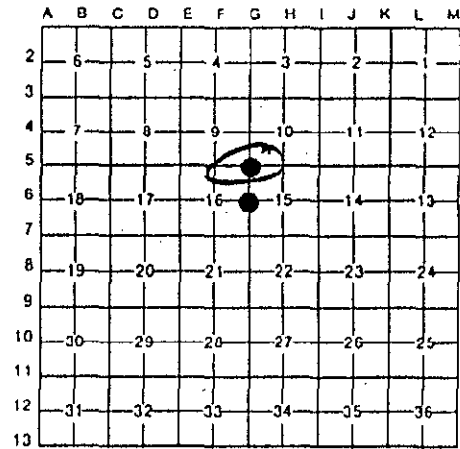

I, Norman C. Caldwell, in a field survey on November, 19 91, do hereby certify that under requirements of P.A. 74, Michigan P.A. of 1970, the corner points mentioned in lines 1 and 2 above were in conformance with regulations and rules therefore as required in the current manual of survey instructions of the United States Department of the Interior, Bureau of Land Management or by a decree of a Court of Law and/or that the corner points mentioned in lines 3, 4 and 5 above were in conformance with the rules of the Michigan Board of Land Surveyors or by a Decree of a Court of Law; established, re-established, monumented, re-monumented, recovered, found as expressed below:

**NOTE:** Not more than 4 corners, all in the same town and range, may be recorded on this certificate.

A. Description of original monument and accessories and/or subsequent restoration:

<u>G-5</u> <u>Sec. cor., 9, 10, 15 &amp; 16</u>	G-6 <u>1/4 cor., Sec. 15 &amp; 16</u>
Post placed by John Brink in 1839 subdivision survey. S31°W 40 lks. (26.4') 12" Beech N43°W 20 lks. (13.2') 10" Beech	Post placed by John Brink in 1839 subdivision survey. N55°W 31 lks. (20.5') 10" White Pine N40°E 07 lks. ( 4.6') 16" White Pine

B. Description of corner evidence found and/or method applied in restoring or reestablishing corner:

<u>G-5</u> <u>Sec. cor., 9, 10, 15 &amp; 16</u>	G-6 <u>1/4 cor., Sec. 15 &amp; 16</u>
Post found by Fargo in 1909 S57°E 25 1/4 lks. (16.8') 16" White Pine N41°W 74 1/4 lks. (49.2') 18" White Pine and placed Fargo monument Found 3/4" iron pipe and limestone under in 1976 by Barnett #16923 S60°E 46.14' 36" White Oak N26°E 62.20' 8" White Oak S74°W 23.73' 6" Maple	U.S. witnesses found by Fargo in 1909. Reestablished cor. and placed Fargo monument. Clinton Cole #17615 placed 1 1/2" pipe in Fargo monument hole. S79°E 22.73' 8" White Oak S32°E 27.31' 6" Maple S79°W 23.62' 8" Maple L 1001, page 717

C. Description of monument for corner and accessories established to perpetuate locating the position of the corner:

<u>G-5</u> <u>Sec. cor., 9, 10, 15 &amp; 16, T22N-R13W</u>	G-6 <u>1/4 Cor., Sec. 15 &amp; 16, T22N-R13W</u>
Found 3/4" pipe & N.F. post near corner and placed 2 1/2" x 30" stainless steel monument and is accepted as a careful and faithful perpetuation of the position of the original corner. S60°E 46.14' 36" W. Oak (R) S35°W 29.07' 10" Poplar S74°W 24.35' 12" Maple (R) N32°E 38.69' 8" Maple South 380'± CL 2 track E-W North 2.0' Carsonite Witness Post	Found 1 1/2" x 32" pipe-fargo iron, lime in bottom on side bank and placed 2 1/2" x 30" stainless steel monument and is accepted as a careful and faithful perpetuation of the position of the original corner. S32°E 27.40' 8" Maple (R) S79°E 22.80' 10" W. Oak (R) S79°W 23.65' 8" Maple (R) N60°E 14.42' 8" Maple North 50.0'± 2 track trail North 0.60' Carsonite Witness Post

*Norman C. Caldwell*  
 16 SEPT 93  
 STATE OF MICHIGAN  
 NORMAN C. CALDWELL  
 PROFESSIONAL SURVEYOR  
 No. 12018

STATE OF MICHIGAN  
 NORMAN C. CALDWELL  
 LAND SURVEYOR  
 REGISTERED LAND SURVEYOR  
 No. 12018

Signed by *Norman C. Caldwell* Date 9 JAN. 1992  
 Surveyor's Michigan License No. 12018

Corner G-5#6-6 ratified by the Manistee County Peer Group pursuant to P.A. 123 of 1915, as amended by P.A. 345 of 1990, and P.A. 319 of 1993