

LAND CORNER RECORDATION CERTIFICATE

FILING REQUIREMENT OF ACT 74, MICH. P.A.1970

FOR CORNERS OF --:	LOCATED IN --:	CORNER CODE NUMBER
1. PUBLIC LAND SURVEY _____	T. <u>22N</u> N. <u>13W</u> E. <u>E.</u> S., R. <u>R.</u> W. <u>W.</u>	K5
2. PROPERTY CONTROLLING IN SECTION _____	T. _____ N. _____ E. _____ S., R. _____ W. _____	
3. MISCELLANEOUS PROPERTY IN SECTION _____	T. _____ N. _____ E. _____ S., R. _____ W. _____	
4. LOT NO. _____, RECORDED PLAT _____		
5. PRIVATE CLAIMS _____		

REGISTER'S OFFICE
MANISTEE COUNTY
#94-245 AT 9:50A.
JUN 15 1994
Penny A. Pearo
REGISTER OF DEEDS

REGISTER OF DEEDS STAMP AND
FILING NUMBER

SURVEY &
REMONUMENTATION
COMMISSION

JUL 14 1994

I, Patrick R. Leemon do hereby certify that under requirements of P. A. 74, Michigan P.A. of 1970, the corner points mentioned in lines 1 and 2 above (identified with circles on index code diagram - over) were, in a field survey on March 30 1994, established, re-established, monumented, re-monumented, recovered or restored as expressed below and in conformance with regulations and rules therefore as required in the current manual of survey instructions of the United States Department of the Interior, Bureau of Land Management or by a decree of a court of law. Furthermore, that the corner points mentioned in lines 3, 4 and 5 above were, in a field survey on _____ 19____, found, recovered, restored, established or re-established as expressed below and in conformance with the rules of the Michigan State Board of Registration for Land Surveyors or, by a Decree of a Court of law:

A. Description of original monument and accessories and/or subsequent restoration:

Section corner common to sections 11, 12 13 and 14 of T22N R13W			#13584
1848 survey by Orange Risdon Set Wood Post	1909 survey by Fargo Eng. Set 1"x30" I.P. w/ lime	1975 survey by Robert A. Griffin Fd. I.P. by Fargo Eng. & replaced it with a 2" x 60" long Iron Pipe with brass cap. Liber 77 Page 37	
#1 Hemlock 13 N52E 21 links	#3 Hemlock 16 S71 1/2 W 21 links	#5 Maple 7 S16E 24.35 feet	
#2 Hemlock 12 S34W 28 links	#4 S. Maple 20 N9 1/2 W 44.5 links	#6 P. Post South 33.03 feet	
	1985 survey by Ed McCombs	#7 Hemlock 5 S14W 34.96 feet	
1908 survey by E.H. Baird Fd. old stake	#10696 Fd. 2" I.P. by Griffin	#8 Hemlock 5 S48W 39.96 feet	
#3 Hemlock 20 S71W 25 links	#9 Maple 6 N38W 37.54 feet	#9 Maple 4 N38W 37.54 feet	
#4 S. Maple 20 N8W 44 links	#5 Maple 8 S16E 24.35 feet		
	#7 Maple 6 S14W 34.96 feet		
	#8 Hemlock 6 S48W 39.96 feet		

B. Description of corner evidence found and/or method applied in restoring or re-establishing corner:
I found the 2" by 60" long Iron Pipe w/ brass cap by Griffin in the center of Cedar Creek. The corner is in the bottom of a steep gully and about 300 feet north of an E-W two track road. A 1990 survey by Clinton Cole #17615 Liber 1 Page 423 used this monument. Witness 7 is a Maple. I could find no evidence of witnesses 2 and 4. Witness 3 is a blown over stump lying partially in the stream. There may be remains of witness 1 to the NE but I am unsure. Witnesses 5 through 9 are in good condition. This monument is accepted as a careful and faithful perpetuation of the position of the original corner.


C. Description of monument for corner and accessories established to perpetuate locating the position of the corner:

Section corner common to sections 11, 12 13 and 14 of T22N R13W
Monu. The 2" by 60" long Iron Pipe with 3" brass disk was left in place.
Witnesses:
S. Maple 9" S16E 24.35 feet (#5)
P. Post 4" South 33.03 feet (#6)
S. Maple 8" S14W 34.96 feet (#7)
Hemlock 7" S48W 39.96 feet (#8)
S. Maple 7" N38W 37.54 feet (#9)

Peer Group
 Manistee County Peer Group
 according to the county plan submitted pursuant to P.A. 345 of 1990,
 as amended, (being the State Survey and Remonument Act, MCL 54.261
 et seq.) - Date of Peer Review: 5/11/94

SIGNED BY *Patrick R. Leemon* DATE April 20, 1994

SURVEYOR'S MICHIGAN REGISTRATION NO. 31595

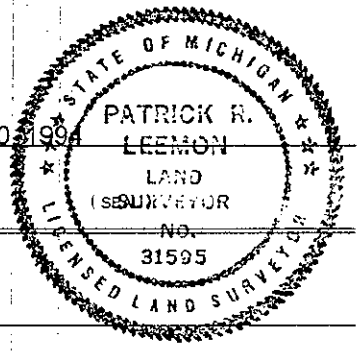

FOR STATE AND UNITED STATES AGENCIES:

SIGNED BY _____ CHIEF OF SURVEY PARTY DATE _____

APPROVED AND SIGNED BY _____ MICHIGAN REGISTERED LAND SURVEYOR DATE _____

SURVEYOR'S MICHIGAN REGISTRATION NO. _____