

LAND CORNER RECORDATION CERTIFICATE

FILING REQUIREMENT OF ACT 74, MICH. P.A.1970

FOR CORNERS OF --:	LOCATED IN --:	CORNER CODE NUMBER
1. PUBLIC LAND SURVEY _____ T. _____ S. _____ R. _____ E. _____ W. _____	22N N. 13W E. S. R. W.	L7
2. PROPERTY CONTROLLING IN SECTION _____ T. _____ S. _____ R. _____ E. _____ W. _____	N. _____ E. _____ S. _____ R. _____ W. _____	_____ SURVEY & REMONUMENTATION _____
3. MISCELLANEOUS PROPERTY IN SECTION _____ T. _____ S. _____ R. _____ E. _____ W. _____	N. _____ E. _____ S. _____ R. _____ W. _____	JUL 14 1994
4. LOT NO. _____, RECORDED PLAT _____		COMMISSION
5. PRIVATE CLAIMS _____		

REGISTER'S OFFICE
MANISTEE COUNTY
 #94-248 AT 9:59 AM.
JUN 15 1994
Penny A. Peters
REGISTER OF DEEDS

REGISTER OF DEEDS STAMP AND FILING NUMBER

I, Patrick R. Leemon do hereby certify that under requirements of P.A. 74, Michigan P.A. of 1970, the corner points mentioned in lines 1 and 2 above (identified with circles on index code diagram - over) were, in a field survey on March 30 1994, established, re-established, monumented, re-monumented, recovered or restored as expressed below and in conformance with regulations and rules therefore as required in the current manual of survey instructions of the United States Department of the Interior, Bureau of Land Management or by a decree of a court of law. Furthermore, that the corner points mentioned in lines 3, 4 and 5 above were, in a field survey on _____ 19____, found, recovered, restored, established or re-established as expressed below and in conformance with the rules of the Michigan State Board of Registration for Land Surveyors or, by a Decree of a Court of law:

A. Description of original monument and accessories and/or subsequent restoration:

- | | | |
|--|--|--|
| <p>1/4 corner common to sections 13 and 24 of T22N R13W</p> <p>1848 survey by Orange Risdon
Set Wood Post
#1 Hemlock 14 N32E 15 links
#2 Hemlock 16 S4E 30 links</p> <p>1908 survey by E.H. Baird
No monument was mentioned
#3 Y. Pine Stp. 18 N61W 55 links
#4 Y. Pine Stp. 24 S42E 42 links</p> | <p>1909 Survey by Fargo Eng.
No monument was set
#5 SW cor. 13 West 39.46 chains
#6 SE cor. 13 East 41.35 chains</p> <p>1976 survey by Clinton Cole #17615
Set 1/2"x18" rebar by Single Prop.
Measurement using Fargo notes.
No witnesses were given</p> | <p>#13584
1976 survey by Robert A. Griffin
Fd. 1/2"x18" rebar by Cole & replaced it w/a 5"x36" conc. monu. with brass cap.
#7 W. Pine 6 N45E 81.12 feet
#8 P. Post 4 N63E 56.82 feet
#9 R. Pine 23 N19W 86.95 feet</p> |
|--|--|--|

B. Description of corner evidence found and/or method applied in restoring or re-establishing corner:

I found the 5" square by 36" long concrete monument w/ brass cap by Griffin buried 6" beneath the surface and 19 feet west of the centerline of the N-S pavement. This monument was used in a 1990 survey by Clinton Cole #17615 in Liber 2 Page 170. Witnesses 1 through 4 are gone. Witnesses 7 through 9 are in good condition. The GLO calls do not aid in determining this location. This corner is in the centerline of the E-W gravel road. I therefore accept the found monument as a careful and faithful reestablishment of the position of the original corner.


C. Description of monument for corner and accessories established to perpetuate locating the position of the corner:

- 1/4 corner common to sections 13 and 24 of T22N R13W**
- Monu. The 5" sq. by 36" long concrete monu. with 3" brass disk was left in place.
- Witnesses:
- W. Pine 10 N45E 81.13 feet (#7)
 - P. Post 4 N63E 56.82 feet (#8)
 - R. Pine 13 S62E 61.58 feet
 - R. Pine 15 S59W 40.40 (OBT)
 - R. Pine 25 N19W 86.95

Corner 7 - ratified by the Manistee County Peer Group according to the county plan adopted pursuant to P.A. 345 of 1990, as amended, (being the State Survey and Remonument Act, MCL 54.261 et. seq.) Date of Peer Review: 5/4/94 *Clinton Cole*

SIGNED BY *Patrick R. Leemon* DATE April 20, 1994

SURVEYOR'S MICHIGAN REGISTRATION NO. 31595

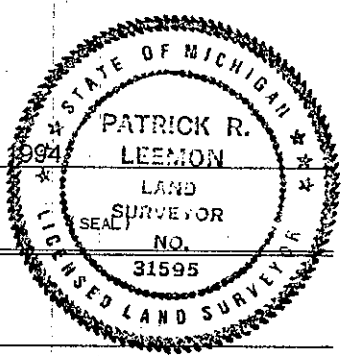

FOR STATE AND UNITED STATES AGENCIES:

SIGNED BY _____ DATE _____
CHIEF OF SURVEY PARTY

APPROVED AND SIGNED BY _____ DATE _____
MICHIGAN REGISTERED LAND SURVEYOR