

MAY 16 1997

COMMISSION

LAND CORNER RECORDATION CERTIFICATE
Filing Requirement of Act 74, Mich. P.A. 1970

For corners in Manistee (County) Located In: Corner Code #
1. Public Land Survey T 22N R 13W M-8
2. Property Controlling in Section S T R
3. Miscellaneous Property in Section S T R
4. Lot No. , Recorded Plat
5. Private Claims

REGISTER'S OFFICE
MANISTEE COUNTY
96-411 at 3:08pm
SEP 23 1996
Deborah Six
REGISTER OF DEEDS

Register of Deeds Stamp & File Number

Grid table with columns A-M and rows 2-13. Contains numbers 6-36.

I, John C. Schulke, in a field survey on May 27th, 1996, do hereby certify that under requirements of P.A. 74, Michigan P.A. of 1970, the corner points mentioned in lines 1 and 2 above were in conformance with regulations and rules therefore as required in the current manual of survey instructions of the United States Department of the Interior, Bureau of Land Management or by a decree of a Court of Law and/or that the corner points mentioned in lines 3, 4 and 5 above were in conformance with the rules of the Michigan Board of Professional Surveyors or by a Decree of a Court of Law; established, re-established, monumented, re-monumented, recovered, found as expressed below:


NOTE: Not more than 4 corners, all in the same town and range, may be recorded on this certificate.

A. Description of original monument and accessories and/or subsequent restoration:
Original survey established in 1837 by J. Brink. Set a wooden post with the following references:
(1) Beech 14" N40°W 57 lks.
(2) Beech 11" S56°W 48 lks.
In 1885, H.S. Udell found post and took following witnesses:
(3) Hemlock 16" N12°E 33 lks.
(4) Hemlock 19" S72°W 22 lks.
(2) Beech S56°W 48 lks.
In 1909, Baird indicated the following references:
(5) Beech 12" S23°30'W 96 lks.
(6) Hemlock 12" S76°30'W 112 lks.
In 1978, R. Wetherell found stake and GLO witness tree Beech. Placed 6" sq. concrete monument with the following references:
(2) Beech 32" S63°W 31.92 ft. GLO
(7) Tw Maple 14" N18°E 20.36 ft.
(8) B. Oak 16" S33°E 26.53 ft.

B. Description of corner evidence found and/or method applied in restoring or reestablishing corner:
Found 6"X6" concrete monument with cap RLS #24624. Found BI'S 2, 7 and 8. References 1, 3, 4, 5 and 6 gone. N-S fence 4 ft. East of monument. Creek is 260 ft± South of corner (GLO 297 ft. South of corner). Monument in fence line running East-West.

Corner M-28 ratified by the Manistee County Peer Group according to the county plan adopted pursuant to P.A. 345 of 1990, as amended, (being the State Survey and Remonument Act, MCL 54.261 et. seq.). Date of Peer Review: JUNE 6, 1996
Anthony M. Stanicki

C. Description of monument for corner and accessories established to perpetuate locating the position of the corner:
Accepted the concrete monument as being the perpetuated location of the original corner. The following corner references:
(2) Beech 34" S71°W 31.37 ft.
(7) Tyn. R Maple 19" N16°E 20.37 ft.
(8) R oak 22" S30°E 26.71 ft.
NBT Sug. Maple 15" N68°W 54.08 ft.
Creek South 260 ft. ±

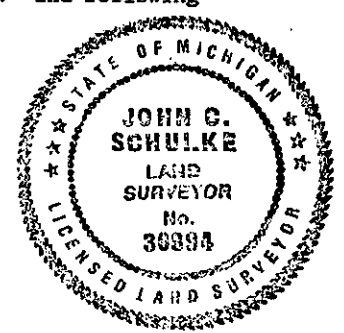

Signed by John C. Schulke
Surveyor's Michigan License No. 30894

Date Sep 9, 1996