

RENEW

MAY 1 1996

LAND CORNER RECORDATION CERTIFICATE
Filing Requirement of Act 74, Mich. P.A. 1970

For corners in

MANISTEE (County)

Located In:

Corner Code #

- 1. Public Land Survey T 22N R 13W M-11
2. Property Controlling in Section S T R
3. Miscellaneous Property in Section S T R

REGISTER'S OFFICE MANISTEE COUNTY

#96-275 HT 9:17 A.M. JUL 01 1996

Penny A. Papp REGISTER OF DEEDS

Register of Deeds Stamp & File Number

- 4. Lot No. , Recorded Plat
5. Private Claims

Grid table with columns A-M and rows 2-13. A dot is present in cell J11.

I, John C. Schulke, in a field survey on May 27th, 1996, do hereby certify that under requirements of P.A. 74, Michigan P.A. of 1970, the corner points mentioned in lines 1 and 2 above were in conformance with regulations and rules therefore as required in the current manual of survey instructions of the United States Department of the Interior, Bureau of Land Management or by a decree of a Court of Law and/or that the corner points mentioned in lines 3, 4 and 5 above were in conformance with the rules of the Michigan Board of Professional Surveyors or by a Decree of a Court of Law; established, re-established, monumented, re-monumented, recovered, found as expressed below:

NOTE: Not more than 4 corners, all in the same town and range, may be recorded on this certificate.

A. Description of original monument and accessories and/or subsequent restoration:

Original survey established in 1837 by J. Brink. Set a wooden post with the following references: (1) cedar 10" S38 1/2 W 24 lks. (2) cedar 9" N30 W 58 lks.

In 1902, H. Knight found Gov't BT (see Book E, page 100 in the Manistee co. Register of Deed's Office). References:

(3) W Pine stump 22" N62 3/4 E 23 lks.

In 1985, R. Griffin (see LCRC 85-8 in the Manistee Co. Register of Deed's Office) found W. pine stump by Knight and set Wexford cast aluminum monument with following references:

- (4) Ash 10" S28 E 17.93 ft.
(5) Cedar 8" N54 W 12.49 ft.
(6) Ash 8" N56 E 29.44 ft.
(7) Cruiser post 8" South 4.0 ft.

In 1989, J. Ray found Wexford Co. Monument and found the following references:

- (4) Elm 12" S28 E 17.93 ft.
(5) Cedar 8" N54 W 12.49 ft.
(6) Elm 6" N56 E 29.44 ft.
(7) cruiser post South 4.0 ft.

(see LCRC, Liber 4, page 48 in the Wexford Co. Register of Deed's Office).

B. Description of corner evidence found and/or method applied in restoring or reestablishing corner:


Found Wexford Co. Monument. Stream 30 feet± South and stream 25 feet± West of the monument. Fence line running East and North. Found references 3, 4, 5, 6 and 7. References 1 and 2 gone. GLO survey calls for stream 0.50 chains South of corner (course West 5 lks. wide). Bearing trees 4 and 6 were identified by me as W Ash not elm trees as found by J. Ray.

Corner M-11 ratified by the Manistee County Peer Group according to the county plan adopted pursuant to P.A. 345 of 1990, as amended, (being the State Survey and Remonument Act, MCL 54.261 et. seq.). Date of Peer Review: Anthony M. Schumaker

C. Description of monument for corner and accessories established to perpetuate locating the position of the corner:

Accepted the Wexford County Monument to represent the perpetuated location of the GLO corner. The following references: (4) W Ash 12" S28 E 17.94 ft. (5) Cedar 10" N53 W 12.48 ft. (6) W Ash 9" N57 E 29.47 ft. NBT B Ash 8" S82 W 33.70 ft. (7) Cruiser post South 4.0 ft. Stream 30 ft.± South that flows Westerly. Stream 25 ft.± West that flows Northwest. Fence line runing North and East from corner.

Position is accepted as a careful and faithful perpetuation of the original corner (see Peer Group Bylaws, Feb. 6th, 1996, page 13 of 14, Part B).

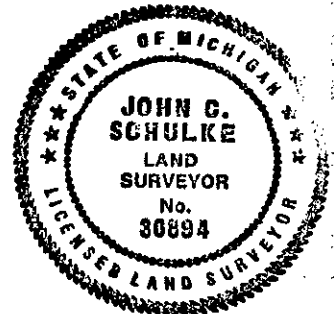

Signed by John C. Schulke

Date June 3, 1996

Surveyor's Michigan License No. 30894