

**SURVEY &
REMONUMENTATION**

OCT 14 1997

COMMISSION

LAND CORNER RECORDATION CERTIFICATE

Filing Requirement of Act 74, Mich. P.A. 1970

For corners in

Manistee
(County)

Located In:

Corner Code #

- | | | | | | | |
|---|---|------------|---|------------|-------------|-------|
| 1. Public Land Survey | T | <u>22N</u> | R | <u>13W</u> | <u>M-12</u> | |
| | T | _____ | R | _____ | _____ | |
| | T | _____ | R | _____ | _____ | |
| | T | _____ | R | _____ | _____ | |
| 2. Property Controlling
In Section | S | _____ | T | _____ | R | _____ |
| | S | _____ | T | _____ | R | _____ |
| 3. Miscellaneous
Property in Section | S | _____ | T | _____ | R | _____ |
| | S | _____ | T | _____ | R | _____ |
4. Lot No. _____, Recorded Plat _____
5. Private Claims _____

**REGISTER'S OFFICE
MANISTEE COUNTY**

#97-263

JUL 25 1997

Penny A. Lepore
REGISTER OF DEEDS

Register of Deeds Stamp & File Number

I, John C. Schulke, in a field survey on June 25th, 19 97, do hereby certify that under requirements of P.A. 74, Michigan P.A. of 1970, the corner points mentioned in lines 1 and 2 above were in conformance with regulations and rules therefore as required in the current manual of survey instructions of the United States Department of the Interior, Bureau of Land Management or by a decree of a Court of Law and/or that the corner points mentioned in lines 3, 4 and 5 above were in conformance with the rules of the Michigan Board of Professional Surveyors or by a Decree of a Court of Law; established, re-established, monumented, re-monumented, recovered, found as expressed below:

NOTE: Not more than 4 corners, all in the same town and range, may be recorded on this certificate.

A. Description of original monument and accessories and/or subsequent restoration:

M-12, East Quarter Corner of Section 36. 22N, R13W
1838 John Brink US Deputy Surveyor Set Wood Post.
Cedar 11" S46°W 37 links (24.4 feet) (1)
Cedar 17" N64°W 8 links (5.3 feet) (2)
Notes call for stream South 2 chains (sta 38+00) 10 links wide flowing West.

10-11-40 on "Yellow Dog" Grover A. Choat, Jr. Forester found cedar stake. Placed location tag on North side of a white cedar post, corner is adjacent. Choat considered the location as being from GLO survey.

Liber 1, Pages 231, dated 5-17-1910 of Tieg Notes, "found old stake and both Gov't wit OK. Put in new cedar stake." (Found in Wexford County Register of Deeds).


B. Description of corner evidence found and/or method applied in restoring or reestablishing corner:

M-12, East Quarter Corner of Section 36. 22N, R13W
Found 3/4" X 4' iron pipe on North side cedar post with location tag. Fences run East, South and West. Found stub of Stub of BT # 1 leaning SW scaring visible. Bears S46°W 25.5 feet. Stump mound bears N64°W 5.4 feet for BT # 2. Steam flowing West, 8 feet wide is South 130 feet from corner.

Found the following BTs with tags showing the distance to corner as follows:

Cedar 4" N06°W 11.82' (3)
W. Birch 12" N76°E 17.85' (4) (dead)

Corner M-12 ratified by the Manistee County Peer Group according to the county plan adopted pursuant to P.A. 345 of 1990, as amended, (being the State Survey and Remonument Act, MCL 54.261 et. seq.). Date of Peer Review JUL 1 1997

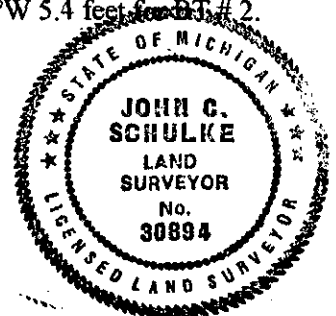

C. Description of monument for corner and accessories established to perpetuate locating the position of the corner:

M-12, East Quarter Corner of Section 36. 22N, R13W

Accepted the position of the pipe I recovered as a careful and faithfully perpetuation of the location of the position of the original corner and replaced with a standard Manistee County Monument placed over the pipe and extending 2" above ground stamped to identify the corner. Corner References:

R. Maple 15" S15°W 32.55 feet (5) (old blaze)	Stub of BT # 1 leaning SW, bears S46°W 25.5 feet.
Cedar 4" S06°E 11.82 feet (3)	Stump mound bears N64°W 5.4 feet for BT # 2.
Hemlock 10" S37°E 14.07 feet (6)	W. Birch 12" S76°W 17.85' (4) (dead)
R Maple 12" N70°E 28.32 feet (7)	

Signed by John C. Schulke
Surveyor's Michigan License No. 30894

Date July 10th, 1997

