REMONUMENTATION
c/o PLANNING DEPARTMENT
(616)723-6041

Manistee County

Manistee County Courthouse • 415 Third Street • Manistee, Michigan 49660

T22N-R14W; west part, Dickson Township
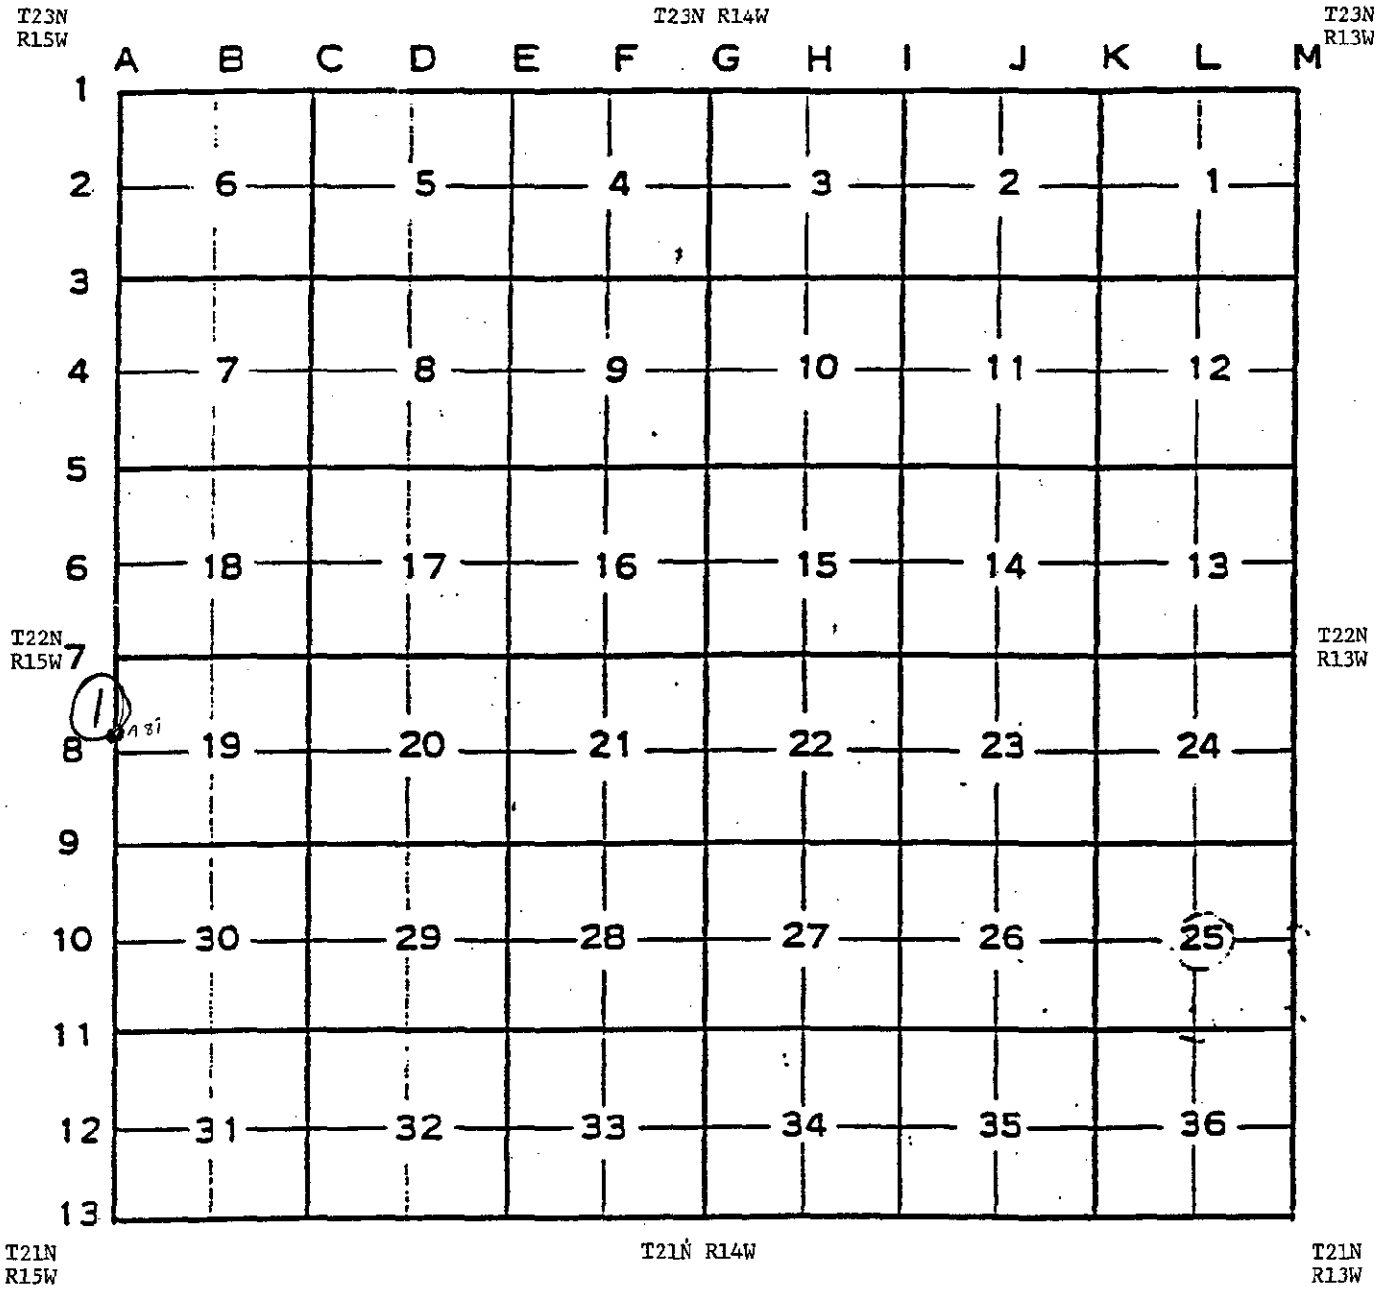
TOWNSHIP CORNER NUMBERING CODE DIAGRAM