

LAND CORNER RECORDATION CERTIFICATE
FILING REQUIREMENT OF ACT 74, MICH. P.A.1970

FOR CORNERS OF-- LOCATED IN-- CORNER CODE NUMBER
1. PUBLIC LAND SURVEY T. 22 N. R. 14 W. L-11; M-9; M-10
2. PROPERTY CONTROLLING IN SECTION T. S. R. E. W.
3. MISCELLANEOUS PROPERTY IN SECTION T. S. R. E. W.
4. LOT NO. , RECORDED PLAT
5. PRIVATE CLAIMS

REGISTER OF DEEDS STAMP AND FILING NUMBER

I, Carl F. Roser do hereby certify that under requirements of P.A. 74, Michigan P.A. of 1970, the corner points mentioned in lines 1 and 2 above (identified with circles on index code diagram - over) were, in a field survey on 6-21 1973, established, re-established, monumented, re-monumented, recovered or restored as expressed below and in conformance with regulations and rules therefore as required in the current manual of survey instructions of the United States Department of the Interior, Bureau of Land Management or by a decree of a court of law.

A. Description of original monument and accessories and/or subsequent restoration:

B. Description of corner evidence found and/or method applied in restoring or re-establishing corner:

- L-11 Recovered Fargo 1" pipe & one NBT
M-9 Recovered Fargo Pipe & NBTs and newer Cons. Power 2" Pipe. Also U.S.F.S. corner of record.
M-10 Recovered Fargo pipe and NBTs.

C. Description of monument for corner and accessories established to perpetuate locating the position of the corner:

Table with 3 columns: L-11, M-9, M-10. Rows describe monuments like 'Fd. Fargo pipe, added DNR Mon & Ced Gd Post' and '4" W. Pine' with bearings and distances.


SIGNED BY Carl F. Roser DATE 7-16-73

SURVEYOR'S MICHIGAN REGISTRATION NO. 12028

FOR STATE AND UNITED STATES AGENCIES:

SIGNED BY CHIEF OF SURVEY PARTY DATE

APPROVED AND SIGNED BY MICHIGAN REGISTERED LAND SURVEYOR DATE

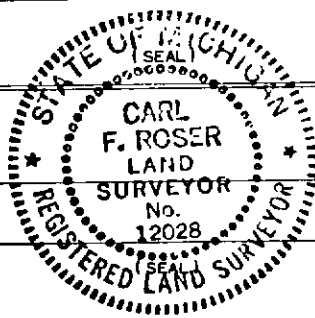

SURVEYOR'S MICHIGAN REGISTRATION NO.