

SURVEY & REMONUMENTATION

APR 03 1996

LAND CORNER RECORDATION CERTIFICATE
Filing Requirement of Act 74, Mich. P.A. 1970

For corners in **COMMISSION**

Manistee
(County)

Located In: Corner Code #

1. Public Land Survey

T 22N R 14W VA7 M-7 of T22N R15W

2. Property Controlling in Section

S ___ T ___ R ___

3. Miscellaneous Property in Sec.

S ___ T ___ R ___

4. Lot No. _____, Recorded Plat _____
5. Private Claims _____

REGISTER'S OFFICE
MANISTEE COUNTY

FEB 2 1993

No. 93-38 AT 9:00 A.M.
REGISTER OF DEEDS

Register of Deeds Stamp & File Number

I, Robert F. Mitchell, in a field survey on May, 19 92, do hereby certify that under requirements of P.A. 74, Michigan P.A. of 1970, the corner points mentioned in lines 1 and 2 above were in conformance with regulations and rules therefore as required in the current manual of survey instructions of the United States Department of the Interior, Bureau of Land Management or by a decree of a Court of Law and/or that the corner points mentioned in lines 3, 4 and 5 above were in conformance with the rules of the Michigan Board of Land Surveyors or by a Decree of a Court of Law; established, re-established, monumented, re-monumented, recovered, found as expressed below:

NOTE: Not more than 4 corners, all in the same town and range, may be recorded on this certificate.

	A	B	C	D	E	F	G	H	I	J	K	L	M
2	6	5	4	3	2	1							
3													
4	7	8	9	10	11	12							
5													
6	18	17	16	15	14	13							
7													
8	19	20	21	22	23	24							
9													
10	30	29	28	27	26	25							
11													
12	31	32	33	34	35	36							
13													

A. Description of original monument and accessories and/or subsequent restoration:

A-7; Northwest Corner Section 19; Originally established during U.S. Survey conducted by J. Brink in 1837 and monumented with a wood post witnessed by a White Pine 20" S72°W 32 Lks and a White Pine 28" N39½°W 23 Lks. In 1901 this corner was regarded as lost by J. Millard, Manistee County Surveyor and re-established by proportionate methods. In 1909 Millard's corner was verified by Fargo Engineering and remonumented with an iron pipe and lime.

B. Description of corner evidence found and/or method applied in restoring or reestablishing corner:


A-7; Northwest Corner Section 19; Found a 1½" by 30" iron pipe "hooked" at the bottom end and in a substantial lime deposit 2 feet North of the physical centerline of a East-West gravel road and in the physical centerline of a gravel road to the North. This monument is entirely consistent with other Fargo Engineering monuments found within the township. Replaced found iron pipe with a 2" by 30" stainless steel pipe with 3" brass cap set 20" below the road surface.

C. Description of monument for corner and accessories established to perpetuate locating the position of the corner:

A-7; Northwest Corner Section 19
2" x 30" Stainless Steel Pipe with 3" Brass Cap, 20" Below the Surface

- N43°E - 10" Red Oak - 82.87'
- S33°E - 18" Red Oak - 119.35'
- S31°W - 9" Red Oak - 108.01'
- N29°W - 14" Red Oak - 146.22'
- S02°W - 1½" iron pipe w/ 2" collar at top - 40.79'
- South - carsonite post - 35'

Corner A-7 ratified by the Manistee County Peer Group pursuant to P.A. 123 of 1915, as amended by P.A. 345 of 1990, amended. Date of Peer Review: JAN 4 1993

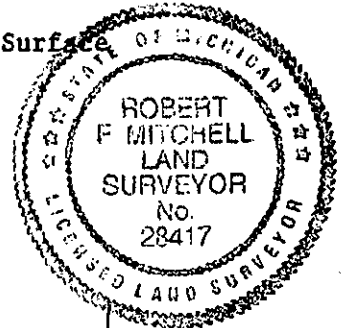

Signed by

Robert F. Mitchell

Date

8/29/92

Surveyor's Michigan License No. 28417