

1993

LAND CORNER RECORDATION CERTIFICATE
Filing Requirement of Act 74, Mich. P.A. 1970

COMMISSION

For corners in

<u>Manistee</u> (County)	Located in:	Corner Code <u>B-7</u>
1. Public Land Survey	T <u>22n</u> R <u>14W</u>	<u>B-7</u>
	T _____ R _____	_____
	T _____ R _____	_____
	T _____ R _____	_____
2. Property Controlling in Section	S _____ T _____ R _____	_____
	S _____ T _____ R _____	_____
3. Miscellaneous Property in Sec.	S _____ T _____ R _____	_____
	S _____ T _____ R _____	_____
4. Lot No. _____, Recorded Plat _____		
5. Private Claims _____		

REGISTER'S OFFICE
MANISTEE COUNTY

FEB 2 1993

NO. 93-42 AT 9:15 A.M.
REGISTER OF DEEDS

Register of Deeds Stamp & File Number

I, Robert F. Mitchell, in a field survey on May, 19 92, do hereby certify that under requirements of P.A. 74, Michigan P.A. of 1970, the corner points mentioned in lines 1 and 2 above were in conformance with regulations and rules therefore as required in the current manual of survey instructions of the United States Department of the Interior, Bureau of Land Management or by a decree of a Court of Law and/or that the corner points mentioned in lines 3, 4 and 5 above were in conformance with the rules of the Michigan Board of Land Surveyors or by a Decree of a Court of Law; established, re-established, monumented, re-monumented, recovered, found as expressed below:

NOTE: Not more than 4 corners, all in the same town and range, may be recorded on this certificate.

A	B	C	D	E	F	G	H	I	J	K	L
2	6	5	4	3	2						
3											
4	7	8	9	10	11	12					
5											
6	18	17	16	15	14	13					
7											
8	19	20	21	22	23	24					
9											
10	30	29	28	27	26	25					
11											
12	31	32	33	34	35	36					
13											

A. Description of original monument and accessories and/or subsequent restoration:

B-7; South 1/2 Corner Section 18; Originally established during U.S. Survey conducted by J. Brink in 1839 and monumented with a wood post witnessed by a Beech 8" N17°E 39 Lks. and a Maple 9" S71°E 42 Lks. This corner was remonumented with an iron pipe and lime by Fargo Engineering in 1909. Fargo Engineering documents state that two old stakes were found but no U.S. evidence was present. In 1935, T. Passmore of the U.S. Forest Service found an iron pipe in agreement with a Fargo Engineering witness of 1909.


B. Description of corner evidence found and/or method applied in restoring or reestablishing corner:

B-7; South 1/2 Corner Section 18; Found 1 1/2" by 35" iron pipe and lime memorial at the south edge of a trail road. Found no evidence of the Fargo Engineering witnesses; however, the existing monument is in agreement with a Passmore witness of 1935. Replaced found iron pipe with a 2" by 30" stainless steel pipe with 3" brass cap set 16" below the trail road surface.

C. Description of monument for corner and accessories established to perpetuate locating the position of the corner:

B-7; South 1/2 Corner Section 18
Set a 2" x 30" Stainless Steel Pipe with 3" Brass Cap 16" below the trail road surface.

- N42°E - 18" Red Oak - 101.98'
- S37°E - 35" White Oak - 156.53'
- S32°W - 11" White Pine - 82.45'
- N61°W - 10" Red Pine - 68.85'
- North - carsonite post - 33'

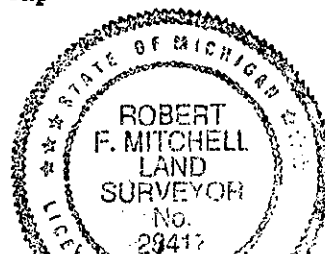

Corner B-7 verified by the Manistee County Peer Group pursuant to P.A. 123 of 1915, as amended by P.A. 365 of 1990, as amended. Date of Peer Review JAN 4 1993

Signed by

Robert F. Mitchell

Date

Feb 19 1992

Surveyor's Michigan License No. 28417