

SURVEY & REMONUMENTATION

OCT 8 1 1994

COMMISSION

LAND CORNER RECORDATION CERTIFICATE

Filing Requirement of Act 74, Mich. P.A. 1970

For corners in

<u>MANISTEE</u> (County)	Located In:	Corner Code #
1. Public Land Survey	T <u>22N</u> R <u>14W</u>	<u>C-6</u>
	T _____ R _____	_____
	T _____ R _____	_____
	T _____ R _____	_____
2. Property Controlling in Section	S _____ T _____ R _____	_____
	S _____ T _____ R _____	_____
3. Miscellaneous Property in Sec.	S _____ T _____ R _____	_____
	S _____ T _____ R _____	_____

REGISTER'S OFFICE
MANISTEE COUNTY
#94-312 AT 3:15 p.m.
JUL 11 1994

Penny A. Peasa
REGISTER OF DEEDS

Register of Deeds Stamp & File Number

- 4. Lot No. _____, Recorded Plat _____
- 5. Private Claims _____

A	B	C	D	E	F	G	H	I	J	K
2	6	5	4	3	2					
3										
4	7	8	9	10	11					
5										
6	18	17	16	15	14					
7										
8	19	20	21	22	23					
9										
10	30	29	28	27	26					
11										
12	31	32	33	34	35					
13										

I, Kenneth L. Ross, in a field survey on JUNE, 1994, do hereby certify that under requirements of P.A. 74, Michigan P.A. of 1970, the corner points mentioned in lines 1 and 2 above were in conformance with regulations and rules therefore as required in the current manual of survey instructions of the United States Department of the Interior, Bureau of Land Management or by a decree of a Court of Law and/or that the corner points mentioned in lines 3, 4 and 5 above were in conformance with the rules of the Michigan Board of Land Surveyors or by a Decree of a Court of Law; established, re-established, monumented, re-monumented, recovered, found as expressed below:

NOTE: Not more than 4 corners, all in the same town and range, may be recorded on this certificate.

A. Description of original monument and accessories and/or subsequent restoration:

- C-6 1/4 Corner, Secs. 17 & 18
- 1836 Brink set Post
- 9" Maple S 22 E 5 lks
- 8" Maple N 35 W 31 lks


B. Description of corner evidence found and/or method applied in restoring or reestablishing corner:

- C-6 1/4 Corner, Secs. 17 & 18
- 1902 Millard set on split between section corners
- Manistee County Records Book A Page 118
- 20" W. Pine Stump S 44 E 37 lks
- 22" W. Pine Stump N 4 E 21.5 lks
- 1994 Ross did not find witness from above survey or any indication of either corner
- Rd 1" X 18" pinched pipe at road P.I.

C. Description of monument for corner and accessories established to perpetuate locating the position of the corner:

- C-6 1/4 Corner, Secs. 17 & 18
- Replaced 1" X 18" pinched pipe with standard Manistee County monument at road P.I., and is accepted as the best available evidence of the original corner.
- Tw. 10" Red Maple N 35 W 43.70'
- Tw. 7" Red Maple N 52 E 63.58'
- 12" Red Maple S 51 W 34.41'
- 16" Red Oak S 34 W 48.26'

ratified by the Manistee County Peer Group according to the county plan adopted pursuant to P.A. 345 of 1990, as amended, (being the State Survey and Remonument Act, MCL 54.261 et. seq.) - Date of Peer Review: APPROVED JUL 11 1994

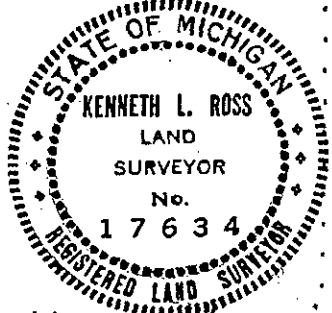

Signed by Kenneth L. Ross

Date July 11, 1994

Surveyor's Michigan License No. 17634