

1993

LAND CORNER RECORDATION CERTIFICATE
Filing Requirement of Act 74, Mich. P.A. 1970

COMMISSION

For corners in

Manistee
(County)

Located In:

Corner Code #

- | | | |
|------------------------------------|---------------------------|---------------------|
| 1. Public Land Survey | T <u>22N</u> R <u>14W</u> | <u>C-8 AND C-8i</u> |
| | T _____ R _____ | _____ |
| | T _____ R _____ | _____ |
| | T _____ R _____ | _____ |
| 2. Property Controlling in Section | S _____ T _____ R _____ | _____ |
| | S _____ T _____ R _____ | _____ |
| 3. Miscellaneous Property in Sec. | S _____ T _____ R _____ | _____ |
| | S _____ T _____ R _____ | _____ |

REGISTER'S OFFICE
MANISTEE COUNTY

FEB 2 1993

No. 93-45 At 9:24 a.m.
REGISTER OF DEEDS

Register of Deeds Stamp & File Number

4. Lot No. _____, Recorded Plat _____
5. Private Claims _____

	A	B	C	D	E	F	G	H	I	J	K	L
2	6		5		4		3		2			
3												
4	7		8		9		10		11		12	
5												
6	18		17		16		15		14		13	
7												
8	19		20		21		22		23		24	
9												
10	30		29		28		27		26		25	
11												
12	31		32		33		34		35		36	
13												

I, Robert F. Mitchell in a field survey on June, 19 92, do hereby certify that under requirements of P.A. 74, Michigan P.A. of 1970, the corner points mentioned in lines 1 and 2 above were in conformance with regulations and rules therefore as required in the current manual of survey instructions of the United States Department of the Interior, Bureau of Land Management or by a decree of a Court of Law and/or that the corner points mentioned in lines 3, 4 and 5 above were in conformance with the rules of the Michigan Board of Land Surveyors or by a Decree of a Court of Law; established, re-established, monumented, re-monumented, recovered, found as expressed below:

NOTE: Not more than 4 corners, all in the same town and range, may be recorded on this certificate.

A. Description of original monument and accessories and/or subsequent restoration:

C-8; West 1/4 Corner Section 20; Originally established during U.S. Survey conducted by J. Brink in 1839 and monumented with a wood post witnessed by a Hemlock 10" N54°E 10 Lks. and a Hemlock 16" N25°W 13 Lks. In 1909 Fargo Engineering found and accepted an old stake. Fargo Engineering documents state that no U.S. evidence was found and that the stake was replaced with an iron lime monument.

B. Description of corner evidence found and/or method applied in restoring or reestablishing corner:


C-8; West 1/4 Corner Section 20; Found a 1 1/2" by 30" iron pipe "hooked" at the bottom end and in a substantial lime deposit. This monument is entirely consistent with other Fargo Engineering monuments found within the township. Replaced found iron pipe with a 2" by 30" stainless steel pipe with 3" brass cap set flush with the ground.

Corner C-8 ratified by the Manistee County Peer Group pursuant to P.A. 123 of 1915, as amended by P.A. 345 of 1990, as amended. Date of Peer Review: JAN 4 1993

C. Description of monument for corner and accessories established to perpetuate locating the position of the corner:

C-8; West 1/4 Corner Section 20 on Indian Reserve Line
Set a 2" x 30" Stainless Steel Pipe with 3" Brass Cap flush with the ground

- N10°E - 12" Hemlock - 11.26'
- S70°E - 11" Hemlock - 19.16'
- S29°W - 10" Hemlock - 49.44'
- S73°W - 14" Hemlock - 16.10'
- North - carsonite post - 1.5'
- East - top of ridge - 47'
- West - thread of Bear Creek - 120'

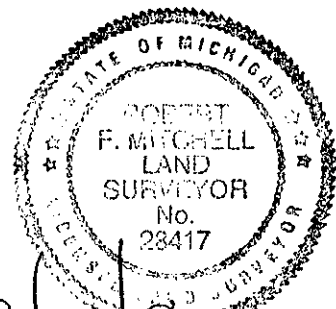

Signed by [Signature] Date 6/11/92
Surveyor's Michigan License No. 28417