

LAND CORNER RECORDATION CERTIFICATE
Filing Requirement of Act 74, Mich. P.A. 1970

1993

For corners in
Manistee
(County)

Located In: Corner Code #

- | | | |
|------------------------------------|---------------------------|------------|
| 1. Public Land Survey | T <u>22N</u> R <u>14W</u> | <u>C-9</u> |
| | T _____ R _____ | _____ |
| | T _____ R _____ | _____ |
| | T _____ R _____ | _____ |
| 2. Property Controlling in Section | S _____ T _____ R _____ | _____ |
| | S _____ T _____ R _____ | _____ |
| 3. Miscellaneous Property in Sec. | S _____ T _____ R _____ | _____ |
| | S _____ T _____ R _____ | _____ |

COMMISSION

REGISTER'S OFFICE
MANISTEE COUNTY

FEB 2 1993

No. 93-46 At 9:25 A.M.
REGISTER OF DEEDS

Register of Deeds Stamp & File Number

4. Lot No. _____, Recorded Plat _____
5. Private Claims _____

	A	B	C	D	E	F	G	H	I	J	K	L	A
2	6	5	4	3	2	1							
3													
4	7	8	9	10	11	12							
5													
6	18	17	16	15	14	13							
7													
8	19	20	21	22	23	24							
9													
10	30	29	28	27	26	25							
11													
12	31	32	33	34	35	36							
13													

I, Robert F. Mitchell in a field survey on May, 19 92, do hereby certify that under requirements of P.A. 74, Michigan P.A. of 1970, the corner points mentioned in lines 1 and 2 above were in conformance with regulations and rules therefore as required in the current manual of survey instructions of the United States Department of the Interior, Bureau of Land Management or by a decree of a Court of Law and/or that the corner points mentioned in lines 3, 4 and 5 above were in conformance with the rules of the Michigan Board of Land Surveyors or by a Decree of a Court of Law; established, re-established, monumented, re-monumented, recovered, found as expressed below:

NOTE: Not more than 4 corners, all in the same town and range, may be recorded on this certificate.

A. Description of original monument and accessories and/or subsequent restoration:

C-9; Southwest Corner Section 20; Originally established during U.S. Survey conducted by O. Risdon in 1847 and monumented with a wood post witnessed by a White Pine 9" N79°W 9 Lks. and a Yellow Pine 9" S79°E 28 Lks. This corner was remonumented with an iron pipe and lime by Fargo Engineering in 1909. Fargo Engineering documents state that one U.S.B.T. and one U.S. Witness Tree were present at the time of remonumentation.

B. Description of corner evidence found and/or method applied in restoring or reestablishing corner:

C-9; Southwest Corner Section 20; Found a 1½" by 32" iron pipe set in lime memorial and in the intersection of trail roads (not following section lines). This monument agrees with an existing Fargo Engineering bearing tree; namely, a White Oak 6" S47½°E 92½ Lks. This tree is now 22" in diameter and healthy. Replaced existing monumentation with a 2" by 30" stainless steel pipe with 3" brass cap and set 12" below trail road surface.

C. Description of monument for corner and accessories established to perpetuate locating the position of the corner:

C-9; Southwest Corner Section 20
Set a 2" x 30" Stainless Steel Pipe with 3" Brass Cap
12" below trail road surface

- N70°E - 8" Red Pine - 58.57'
- S08°E - 8" White Pine - 74.33'
- S23°W - 10" White Pine - 48.90'
- N55°W - 13" White Oak - 48.19'
- East - carsonite post - 15'


Signed by

Robert F. Mitchell

Date

2/11/92

Surveyor's Michigan License No. 28417

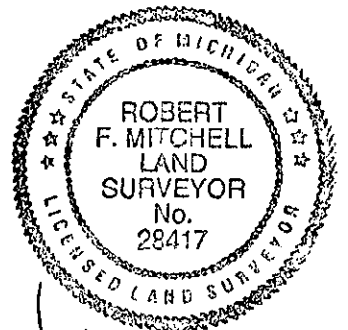

Corner C-9 ratified by the Manistee County Peer Group pursuant to P.A. 123 of 1915, as amended by P.A. 345 of 1990, as amended. Date of Peer Review: JAN - 4 1993